

APR 05 1996

Ottawa County Remonumentation

COMMISSION

LAND CORNER RECORDATION CERTIFICATE

Filing Requirement of Act 74, Mich. P.A. 1970

For corners in

<u>Ottawa</u> <small>(County)</small>	Located In:	Corner Code #
1. Public Land Survey	T <u>T7N</u> R <u>R13W</u>	<u>M-7</u>
	T ___ R ___	(SE cor of
	T ___ R ___	Section 13)
	T ___ R ___	Tallmadge Twp
2. Property Controlling in Section	S ___ T ___ R ___	_____
	S ___ T ___ R ___	_____
3. Miscellaneous Property in Sec.	S ___ T ___ R ___	_____
	S ___ T ___ R ___	_____
4. Lot No. _____, Recorded Plat _____		
5. Private Claims _____		

RECORDED

95 NOV 29 PM 1:44

Ronald S. Hollman
REGISTER OF DEEDS
OTTAWA COUNTY, MI

Register of Deeds Stamp & File Number

I, Maurice J. Rosema, in a field survey on March 3, 19 95, do hereby certify that under requirements of P.A. 74, Michigan P.A. of 1970, the corner points mentioned in lines 1 and 2 above were in conformance with regulations and rules therefore as required in the current manual of survey instructions of the United States Department of the Interior, Bureau of Land Management or by a decree of a Court of Law and/or that the corner points mentioned in lines 3, 4 and 5 above were in conformance with the rules of the Michigan Board of Land Surveyors or by a Decree of a Court of Law; established, re-established, monumented, re-monumented, recovered, found as expressed below:

NOTE: Not more than 4 corners, all in the same town and range, may be recorded on this certificate.

A	B	C	D	E	F	G	H	I	J	K	L
2	6	5	4	3	2						
3											
4	7	8	9	10	11						
5											
6	18	17	16	15	14						
7											
8	19	20	21	22	23						
9											
10	30	29	28	27	26						
11											
12	31	32	33	34	35						
13											

A. Description of original monument and accessories and/or subsequent restoration:
M-7


GLO - 1837 (Noah Brookfield D.S.) 10" Beech S24°W 23lks 12" Beech N18°W 53lks	L.C.R.C. recorded in Liber 2, Page 471 - April 20, 1974 (over)	L.C.R.C. recorded as no. 1844 - June 10, 1981 (over)
L.C.R.C. recorded in Liber 2, Page 818 - April 29, 1975 (over)	L.C.R.C. recorded in Liber 6, Page 89 - October 31, 1990 (over)	
	L.C.R.C. recorded in Liber 5, Page 175 - December 17, 1984	L.C.R.C. recorded as no. 5501 - May 14, 1990 (over)

B. Description of corner evidence found and/or method applied in restoring or reestablishing corner:
M-7

Found C.I. monument in monument box
Found nail in 36" Poplar SW 40.74'
Found nail in 16" Ash ESE 94.22'
Found nail in P.Pole WNW 43.45'
Found nail in Flag pole NE 70.57'

RA. 345 OTTAWA COUNTY
PEER APPROVED 11-20-95

Maurice J. Rosema
M.J.R.

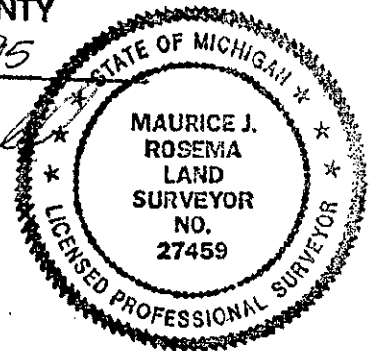

I hereby accept this corner as a correct and accurate perpetuation of the position of the original corner.

C. Description of monument for corner and accessories established to perpetuate locating the position of the corner:
M-7

Found C.I. monument in monument box	
Found nail and Kent County remon. tag in NW side 36" Poplar	S39°W 40.74'
Found nail and Kent County remon. tag in E side P pole	S22°W 49.26'
Found nail and Kent County remon. tag in N side 16" Ash	S75°E 94.22'
Found nail and Kent County remon. tag in NE side p pole	N52°W 43.45'
c/l flag pole	N49°E 70.57'
c/l E-W bit. conc. road	N 1'

Signed by *Maurice J. Rosema*
Surveyor's Michigan License No. 27459

Date October 21, 1995

M-7, T7N, R13W

L.C.R.C. recorded in Liber 2, Page 471
- April 20, 1974

1" Iron	
Nail in 10" Ash	ESE 60.10'
Nail in T pole	SSW 49.29'
Center of 4" gas vent pipe	NE 48.0'
Nail in P pole	NW 43.58'
SE cor. brick garage	NNW 111.50'

L.C.R.C. recorded in Liber 2, Page 818
- April 29, 1975

2" iron	
10" Ash	ESE 60.10'
T pole	SSW 94.29'
4" vent pipe	NE 48.0'
P pole	NW 43.58'
SE cor garage	NNW 111.50'

L.C.R.C. recorded in Liber 5, Page 175
- December 14, 1984

C.I. monument	
TP	NW 43.58'
30" Ash	SW 40.49'
12" Ash	ESE 94.65'
c/l flagpole	NE 70.53'

L.C.R.C. recorded in 6, Page 89
- October 31, 1990

C.I. monument	
PP	NW 43.46'
36" poplar	SW 40.78'
c/l gas vent	NE 29.51'
SE corner garage	NNW 111.55'
16" Ash	ESE 94.17'

L.C.R.C. recorded as no. 1844
- June 10, 1981 (recorded as A-7, T7N, R12W)

K.C. Harrison monument	
K.C. nail and tag in 34" Ash	S40°W 40.50'
K.C. nail and tag in T pole	N47°W 43.43'
K.C. nail and tag in 12" Ash	S85°E 94.70'
Face of gas line marker	N16°E 29.35'

L.C.R.C. recorded as no. 5501
- May 14, 1990 (recorded as A-7, T7N, R12W)

K.C. monument	
Nail and K.C. tag in W side 36" Ash	S40°W 40.77'
Nail and K.C. tag in N side T pole	N55°W 43.43'
Nail and K.C. tag in S side 14" Ash	S75°E 94.11'
Face of gas line marker	N30°E 29.40'
c/l of E-W bit. road is 1' N	

\$ 11.00 CORNER