

APR 05 1996

Ottawa County Remonumentation

COMMISSION LAND CORNER RECORDATION CERTIFICATE

Filing Requirement of Act 74, Mich. P.A. 1970

For corners in

<u>Ottawa</u> <small>(County)</small>	Located In:	Corner Code #
1. Public Land Survey	T <u>7N</u> R <u>13W</u>	M-11
	T ___ R ___	(SE cor of
	T ___ R ___	Section 25)
	T ___ R ___	Tallmadge Twp
2. Property Controlling in Section	S ___ T ___ R ___	
	S ___ T ___ R ___	
3. Miscellaneous Property in Sec.	S ___ T ___ R ___	
	S ___ T ___ R ___	

RECORDED

95 NOV 29 PM 1:44

Phyllis Chubb
REGISTER OF DEEDS
OTTAWA COUNTY, MI

Register of Deeds Stamp & File Number

4. Lot No. _____, Recorded Plat _____
5. Private Claims _____

	A	B	C	D	E	F	G	H	I	J	K	L	M
2	6	5	4	3	2	1							
3													
4	7	8	9	10	11	12							
5													
6	18	17	16	15	14	13							
7													
8	19	20	21	22	23	24							
9													
10	30	29	28	27	26	25							
11													
12	31	32	33	34	35	36							
13													

I, Maurice J. Rosema, in a field survey on March 10, 1995, do hereby certify that under requirements of P.A. 74, Michigan P.A. of 1970, the corner points mentioned in lines 1 and 2 above were in conformance with regulations and rules therefore as required in the current manual of survey instructions of the United States Department of the Interior, Bureau of Land Management or by a decree of a Court of Law and/or that the corner points mentioned in lines 3, 4 and 5 above were in conformance with the rules of the Michigan Board of Land Surveyors or by a Decree of a Court of Law; established, re-established, monumented, re-monumented, recovered, found as expressed below:

NOTE: Not more than 4 corners, all in the same town and range, may be recorded on this certificate.

A. Description of original monument and accessories and/or subsequent restoration:
M-11

GLO - 1837 (Noah Brookfield D.S.)	L.C.R.C. recorded in Liber 3, Page 138	L.C.R.C. recorded as no. 5505
12" Tam N29°W 27 lks	- November 29, 1976 (over)	- June 6, 1990
9" Tam S66°W 23 lks		(over)
L.C.R.C. recorded in Liber 5	L.C.R.C. recorded in Liber 5, Page 161	(recorded as
Page 211 - May 21, 1985	- November 5, 1984 (over)	A-11, T7N, R12W)
(over)	L.C.R.C. recorded as no. 1473	
	- Feb. 4, 1981 (over)	
	(recorded as A-11, T7N, R12W)	


B. Description of corner evidence found and/or method applied in restoring or reestablishing corner:
M-11

Found C.I. Monument	
Found nail and Kent County remon. tag in SW side tri 6" Maple	N49°E 18.05'
Found nail and Kent County remon. tag in NE side 15" Maple	S50°E 67.82'
Found nail and Kent County remon. tag in SE side 8" Maple	S80°W 4.00'
Found nail and Kent County remon. tag in SW side 12" tw Maple	N48°W 33.18'

I hereby accept this corner as a correct and accurate perpetuation of the position of the original corner.

C. Description of monument for corner and accessories established to perpetuate locating the position of the
M-11
C.I. Monument

Found nail and Kent County remon. tag in SE side 6" tri Maple	N49°E 18.05'
Found nail and Kent County remon. tag in NE side 15" Maple	S50°E 67.82'
Found nail and Kent County remon. tag in SE side 8" Maple	S80°W 4.00'
Found nail and Kent County remon. tag in SW side 12" tw Maple	N48°W 33.18'

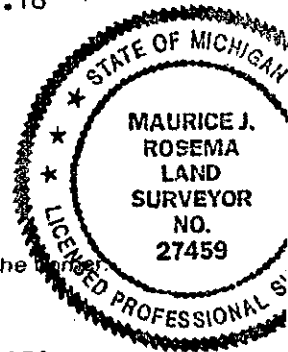

P.A. 345 OTTAWA COUNTY

PEER APPROVED 11-20-95

Richard D. Redwood

Date October 21, 1995

Signed by Maurice J. Rosema
Surveyor's Michigan License No. 27459

M-11, T7N, R13W

L.C.R.C. recorded in Liber 3, Page 138
- November 29, 1976

Rock
6" Maple NE 9.22'
Tw Willow S 8.70'
Sq wood post SE 6.60'

L.C.R.C. recorded in Liber 5, Page 211
- May 21, 1985

C.I. Monument
30" Maple SSW 90.87'
10" Maple SE 54.45'
14" Maple N 34.15'
14" Maple ESE 67.78'
10" Maple NW 32.98'
6" tri Maple NE 17.95'
Face 2" steel post NW 0.40'

L.C.R.C. recorded in Liber 5, Page 161
- November 5, 1984
Kent County Monument

L.C.R.C. recorded as no. 1473
- February 4, 1981 (recorded as A-11, T7N, R12W)
Monument

Nail and K.C. remon. tag in W side 30" Maple	S15°E 90.87'
Nail and K.C. remon. tag in SW side 10" Maple	S45°E 54.45'
Nail and K.C. remon. tag in E side 14" Maple	N 34.15'
Nail and K.C. remon. tag in N side 14" Maple	S60°E 67.78'
Nail and K.C. remon. tag in S side 10" Maple	N45°W 32.98'
Nail and K.C. remon. tag in SE side 6" tri Maple	N45°E 17.95'
Face of 2" dia. steel post	N35°W 0.40'

L.C.R.C. recorded as no. 5505
- June 6, 1990 (recorded as A-11, T7N, R12W)

K.C. Monument	
Nail and K.C. tag in W side 30" Maple	S15°E 90.87'
Nail and K.C. tag in E side 14" Maple	N 34.15'
Nail and K.C. tag in N side 14" Maple	S60°E 67.78'
Nail and K.C. tag in S side 10" Maple	N45°W 33.08'
Nail and K.C. tag in SE side 6" tri Maple	N45°E 18.01'
Face 2" dia steel post	N35°W 0.40'

\$ 11.00
CORNER