

APR 05 1996

Ottawa County Remonumentation

COMMISSION LAND CORNER RECORDATION CERTIFICATE
Filing Requirement of Act 74, Mich. P.A. 1970

For corners in

<u>Ottawa</u> <small>(County)</small>	Located In:	Corner Code #
1. Public Land Survey	T <u>T7N</u> R <u>R13W</u>	M-12
	T _____ R _____	(E $\frac{1}{2}$ cor of
	T _____ R _____	Section 36)
	T _____ R _____	Tallmadge Twp
2. Property Controlling in Section	S _____ T _____ R _____	_____
	S _____ T _____ R _____	_____
3. Miscellaneous Property in Sec.	S _____ T _____ R _____	_____
	S _____ T _____ R _____	_____
4. Lot No. _____, Recorded Plat _____		
5. Private Claims _____		

RECORDED

95 NOV 29 PM 1:46

Rhonda R. Robinson
REGISTER OF DEEDS
OTTAWA COUNTY, MI

Register of Deeds Stamp & File Number

Maurice J. Rosema in a field survey on February 24, 1995
do hereby certify that under requirements of P.A. 74, Michigan P.A. of 1970, the corner points mentioned in lines 1 and 2 above were in conformance with regulations and rules therefore as required in the current manual of survey instructions of the United States Department of the Interior, Bureau of Land Management or by a decree of a Court of Law and/or that the corner points mentioned in lines 3, 4 and 5 above were in conformance with the rules of the Michigan Board of Land Surveyors or by a Decree of a Court of Law; established, re-established, monumented, re-monumented, recovered, found as expressed below:

A	B	C	D	E	F	G	H	I	J	K	L	I
2	6	5	4	3	2	1						
3												
4	7	8	9	10	11	12						
5												
6	18	17	16	15	14	13						
7												
8	19	20	21	22	23	24						
9												
10	30	29	28	27	26	25						
11												
12	31	32	33	34	35	36						
13												

NOTE: Not more than 4 corners, all in the same town and range, may be recorded on this certificate.

A. Description of original monument and accessories and/or subsequent restoration:

M-12
GLO - 1837 (Noah Brookfield D.S.)
30" Red Oak S15°W 41 lks
10" Red Oak N27°W 33 lks


L.C.R.C. recorded in Liber 6,
Page 6 - October 31, 1990
(over)

L.C.R.C. recorded as no. 5506
- May 14, 1990 (recorded as A-12, T7N, R12W)
P.A. 345 OTTAWA COUNTY
PEER APPROVED 11-20-95

Andrey D. Nedowald
MDN

B. Description of corner evidence found and/or method applied in restoring or reestablishing corner:

M-12
Found C.I. monument
Found nail and Kent County remon. tag in SE side P pole N83°W 29.69'
Found nail and Kent County remon. tag in NE side 10" Pine S32°E 58.61'
Found nail and Kent County remon. tag in N side 12" Hickory S28°W 31.45'
SW corner garage N76°E 98.58'

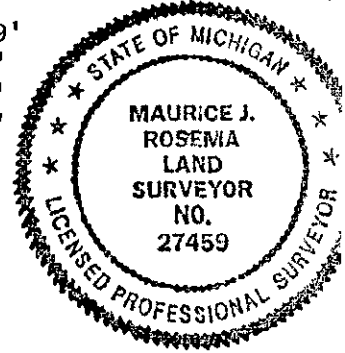

I hereby accept this corner as a correct and accurate perpetuation of the position of the original corner.

C. Description of monument for corner and accessories established to perpetuate locating the position of the corner:

M-12
Found C.I. monument
Found nail and Kent County remon. tag in SE side P pole N83°W 29.69'
Found nail and Kent County remon. tag in NE side 10" Pine S32°E 58.61'
Found nail and Kent County remon. tag in N side 12" Hickory S28°W 31.45'
SW corner of garage N76°E 98.58'
c/l N-S bit. conc. road E 3'
Tree row to W N 3'

Signed by *Maurice J. Rosema* Date October 21, 1995
Surveyor's Michigan License No. 27459

M-12, T7N, R13W

L.C.R.C. recorded in Liber 6, Page 83

- October 31, 1990

C.I. monument

PP	NW 29.67'
12" Hickory	SW 31.45'
10" Pine	SE 58.84'
SW cor. gar.	NE 98.54'

L.C.R.C. recorded as no. 5506

- May 14, 1990 (recorded as A-12, T7N, R12W)

K.C. monument

Nail and K.C. remon. tag in N side P and T pole	N85°W 29.65'
Nail and K.C. remon. tag in NE side 8" Pine	S35°E 58.77'
NE cor. brick house	N50°W 110.00'
SW cor. brick garage	N70°E 98.53'
Nail and K.C. remon. tag in SW side 12" Walnut	S25°W 31.42'
On E-W tree lines	
c/l N-S gravel road	E 4' m/l

* 11.00 CORNER