FEB 24 2000

SECTION

RECORDED

99 SEP 23 PM 3:20

REGISTER OF DEEDS
OTTAWA COUNTY, MI

OTTAWA COUNTY REMONUMENTATION

LAND CORNER RECORDATION CERTIFICATE
Filing Requirement of Act 74, Mich. P.A. 1970

For corners in

OTTAWA
(County)

	Located In:	Corner Code #
1. Public Land Survey	T 7N R 13W	I-5 NW Corner
	T___ R___	Section 14,
	T___ R___	Tallmadge
	T___ R___	~~Township~~
2. Property Controlling in Section	S___ T___ R___	
	S___ T___ R___	
3. Miscellaneous Property in Sec.	S___ T___ R___	
	S___ T___ R___	

Sep. 2

Register of Deeds Stamp & File Number

4. Lot No. _____, Recorded Plat _____
5. Private Claims _____

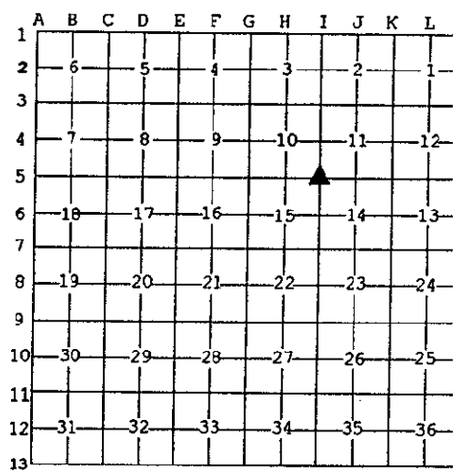

I, Randal J. Vugteveen, in a field survey on August 25, 19 99 do hereby state that under requirements of P.A. 74, Michigan P.A. of 1970, the corner points mentioned in lines 1 and 2 above were in conformance with regulations and rules therefore as required in the current manual of survey instructions of the United States Department of the Interior, Bureau of Land Management or by a decree of a Court of Law and /or that the corner points mentioned in lines 3, 4 and 5 above were in conformance with the rules of the Michigan Board of Land Surveyors or by a Decree of a Court of Law; established, re-established, monumented, recovered, found as expressed below:

NOTE: Not more than 2 corners, all in the same town and range, may be recorded on this certificate.

A. Description of original monument and accessories and/or subsequent restoration:

I-5 Ottawa County Remonumentation Certificate
Liber 1, Page 206 Rosema 1993
I-5 C.I. monument
Nail and Remon Tag NE side 17" Oak S57°E 54.85'
Nail and Remon Tag W side 22" Ash N23° W 40.92'
Nail and Remon Tag SE side 22" Ash N46°W 41.30'
Nail and Remon Tag N side 28" Ash S42°W 30.46'
Nail and Remon Tag SE side 17" Ash N44°E 43.45'
Centerline E-W gravel road South 4' +/-

9/13/99
GDV

B. Description of corner evidence found and/or method applied in restoring or reestablishing corner:

I-5 Found busted C.I. Monument June 3, 1999

Fnd Nail & Remon Tag NE side 17" Oak S57°E 54.84'
Fnd Nail & Remon Tag W side 18" Ash N23°W 40.92'
Fnd Nail & Remon Tag SE side (face) 18" Ash N46°W 41.28'
Fnd Nail & Remon Tag SE side 17" Ash N44°E 43.43'

(Ottawa County Road Commission is rebuilding the road at this time).
Accepted busted Cast Iron Monument as a careful and faithful perpetuation of the position of the original corner.
Set Witness Iron Control outside of construction.

August 25, 1999 recovered witness irons and set 3/4" X 24" Iron Bar with Remonumentation Cap

C. Description of monument for corner and accessories established to perpetuate locating the position of the corner:

I-5 3/4" X 24" iron bar with Ottawa County Remonumentation Cap

Found Nail and Ottawa County Remon Tag in NE side 17" Oak S57°E 54.84'
Found Nail and Ottawa County Remon Tag in W side 18" Ash N23°W 40.92'
Found Nail and Ottawa County Remon Tag in SE side (face) 18" Ash N46°W 41.28'
Found Nail and Ottawa County Remon Tag in SE side 17" Ash N44°E 43.43'
Centerline (new) E & W Gravel Road South 4.0' (To be paved soon)

STATE OF MICHIGAN
RANDALL J. VUGTEVEEN
NO. 28429
LICENSED LAND SURVEYOR

$9.00 CORNER
Receipt #58324

$1.00 PHOTO
Receipt #58324

Signed by _____ Date 9/12/99

Surveyor's Michigan License No. 28429

FORM APPROVED BY MICHIGAN STATE BOARD OF PROFESSIONAL SURVEYORS, JAN. 28, 1971
REVISED MAY 14,1975
REVISED JAN., 1983
REVISED OCT., 1995