


SURVEY &
REMONUMENTATION

DEC 01 1998

SECTION

A-8
ALLENDALE TOWNSHIP

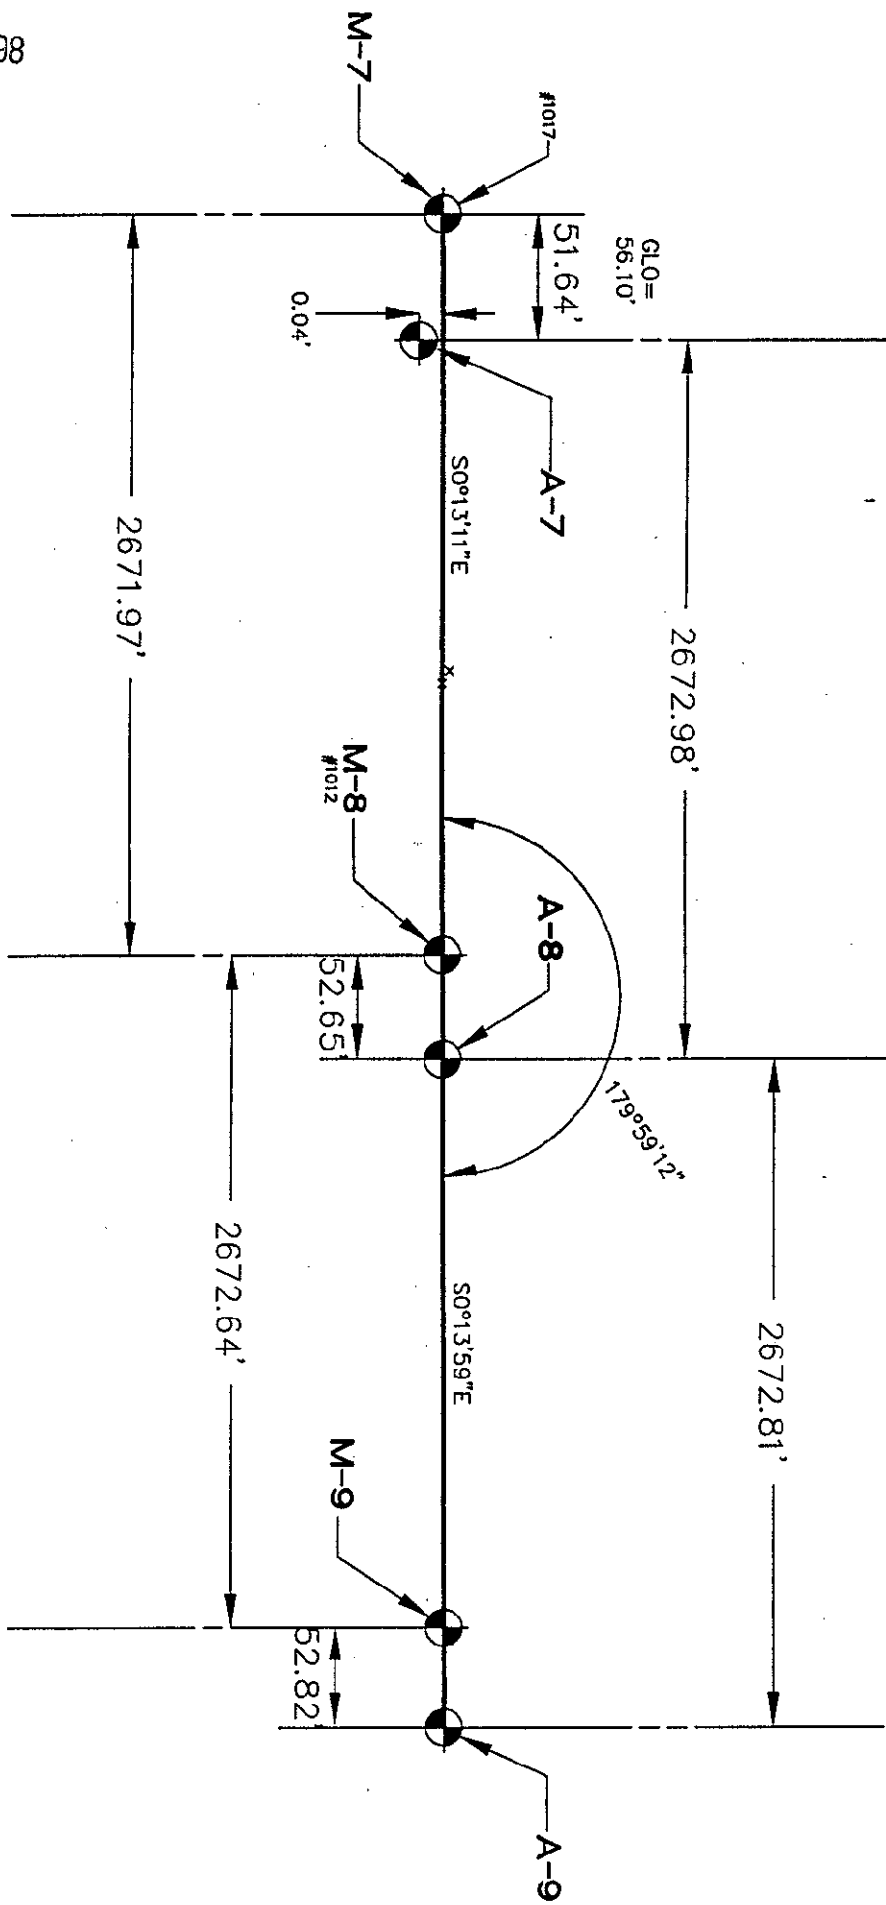

NO SCALE