

**SURVEY & REMONUMENTATION**

APR 05 1996

Ottawa County Remonumentation  
**LAND CORNER RECORDATION CERTIFICATE**  
 Filing Requirement of Act 74, Mich. P.A. 1970

For corners in **COMMISSION**

<u>Ottawa</u> (County)	Located In:	Corner Code #
1. Public Land Survey	T <u>T7N</u> R <u>R14W</u>	A-13
	T _____ R _____	(SW cor of
	T _____ R _____	Section 31)
	T _____ R _____	Allendale Twp
2. Property Controlling in Section	S _____ T _____ R _____	_____
	S _____ T _____ R _____	_____
3. Miscellaneous Property in Sec.	S _____ T _____ R _____	_____
	S _____ T _____ R _____	_____

**RECORDED**  
 95 NOV 29 PM 1:47  
*Phyllis Williams*  
 REGISTER OF DEEDS  
 OTTAWA COUNTY, MI  
**Register of Deeds Stamp & File Number**

4. Lot No. \_\_\_\_\_, Recorded Plat \_\_\_\_\_  
 5. Private Claims \_\_\_\_\_

A	B	C	D	E	F	G	H	I	J	K	L
2	6	5	4	3	2	1					
3											
4	7	8	9	10	11	12					
5											
6	18	17	16	15	14	13					
7											
8	19	20	21	22	23	24					
9											
10	30	29	28	27	26	25					
11											
12	31	32	33	34	35	36					
13											

I, Maurice J. Rosema, in a field survey on Sept. 6, 19 95, do hereby certify that under requirements of P.A. 74, Michigan P.A. of 1970, the corner points mentioned in lines 1 and 2 above were in conformance with regulations and rules therefore as required in the current manual of survey instructions of the United States Department of the Interior, Bureau of Land Management or by a decree of a Court of Law and/or that the corner points mentioned in lines 3, 4 and 5 above were in conformance with the rules of the Michigan Board of Land Surveyors or by a Decree of a Court of Law; established, re-established, monumented, re-monumented, recovered, found as expressed below:

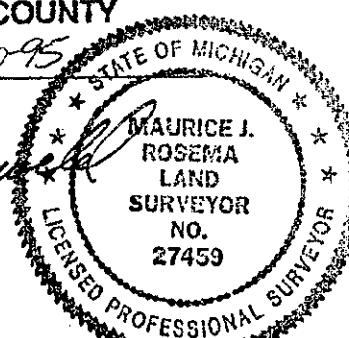
**NOTE: Not more than 4 corners, all in the same town and range, may be recorded on this certificate.**

A. Description of original monument and accessories and/or subsequent restoration:

A-13  
 Glo - 1837 (John Mullett D.S.) L.C.R.C. recorded in Liber 6  
 12" Beech S59°W 25 lks Page 148 - May 7, 1991 (over)  
 9" Beech N47°E 22 lks  
 L.C.R.C. recorded in Liber 4 L.C.R.C. recorded in Liber 4  
 Page 79 - June 30, 1980 Page 154 - June 30, 1980 (over)  
 (over)

B. Description of corner evidence found and/or method applied in restoring or reestablishing corner:

A-13  
 Found C.I. Monument in monument box  
 Found nail in 26" Maple ESE 52.95' PEER APPROVED 11-20-95  
 Found nail in P.pole WNW 70.49'  
 Found nail in P.pole NNW 84.22'

**P.A. 345 OTTAWA COUNTY**  
  
*M. J. Rosema*

I hereby accept this corner as a correct and accurate perpetuation of the position of the original corner.

C. Description of monument for corner and accessories established to perpetuate locating the position of the corner:

A-13  
 C.I. monument in monument box  
 Set nail and Ottawa County remon. tag in NE side 26" Maple S52°E 52.95'  
 Set nail and Ottawa County remon. tag in S side P. pole N69°E 76.92'  
 Set nail and Ottawa County remon. tag in N side P. pole N52°W 70.49'  
 Set nail and Ottawa County remon. tag in N side cut-off P pole N38°W 84.22'  
 Set nail and Ottawa County remon. tag in N side 14" Elm S55°W 64.10'  
 Found PK nail in bit. conc. road S87°E 69.97'  
 c/l N-S bit. conc. road W 7'  
 On c/l E-W bit. conc. road

Signed by *M. J. Rosema* Date October 21, 1995  
 Surveyor's Michigan License No. 27459

A-13, T7N, R14W

L.C.R.C. recorded in Liber 4, Page 154

- March 18, 1981

C.I. monument

P pole	NW 83.77'
T pole	NE 48.20'
34" Oak	ENE 59.39'
21" Maple	SE 52.18

L.C.R.C. recorded in Liber 6, Page 148

- August 22, 1991 (recorded as M-13, T7N, R15W)

Cast monument

16-d in S side P pole	N35°W 83.79'
Nail and tag in N side 24" Maple	S50°E 52.91'
16-d in W side 16" Maple	S15°E 145.52'
PK in E edge pavement	S10°E 60.62'
SE corner house	S40°W 136.24'
16-d in S side 12" Elm	S55°W 64.16'

L.C.R.C. recorded in Liber 4, Page 79

- July 1, 1980 (recorded as A-1, T6N, R14W)

C.I. monument

P pole	NW 83.77'
T pole	NE 48.20'
34" Oak	ENE 59.39'
21" Maple	SE 52.18'

\$ 11.00 CORNER