

SURVEY & REMONUMENTATION

JUN 28 1999

Ottawa County Remonumentation

RECORDED

98 NOV -4 PH 2:30

SECTION

LAND CORNER RECORDATION CERTIFICATE
Filing Requirement of Act 74, Mich. P.A. 1970

For corners in

Ottawa (County)	Located In:	Corner Code #
1. Public Land Survey	7N 14W	B-7
	T R	N 1/4, cor. Sec. 19
	T R	Allendale Township
	T R	
	T R	
2. Property Controlling in Section	S T R	
	S T R	
3. Miscellaneous Property in Sec.	S T R	
	S T R	


Ray [Signature]
REGISTER OF DEEDS
OTTAWA COUNTY, MI

Register of Deeds Stamp & File Number

4. Lot No. _____, Recorded Plat _____
5. Private Claims _____

I, Maurice J. Rosema, in a field survey on Oct. 17, 1998 do hereby state that under requirements of P.A. 74, Michigan P.A. of 1970, the corner points mentioned in lines 1 and 2 above were in conformance with regulations and rules therefore as required in the current manual of survey instructions of the United States Department of the Interior, Bureau of Land Management or by a decree of a Court of Law and/or that the corner points mentioned in lines 3, 4 and 5 above were in conformance with the rules of the Michigan Board of Land Surveyors or by a Decree of a Court of Law, established, re-established, monumented, recovered, found as expressed below.

NOTE: Not more than 2 corners, all in the same town and range, may be recorded on this certificate.

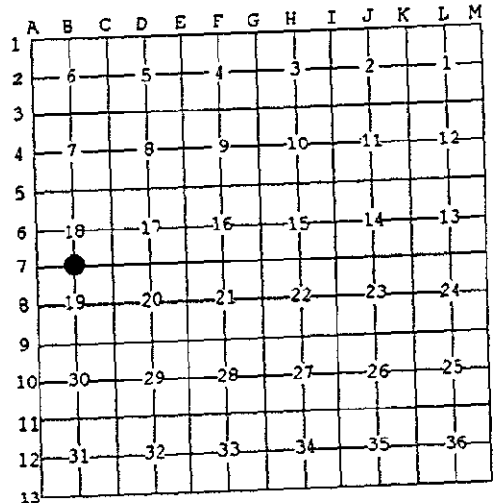

A. Description of original monument and accessories and/or subsequent restoration:

- B-7
GLO - 1832 by Calvin Britain
Set post
10" Hemlock - N25°W 14 links
16" Hemlock - S16°W 33 links
LCRC rec. Liber 4, Page 38 (1980 - Byl)
C.I. mon.
Power pole - ESE 95.10'
- LCRC rec. Liber 1, Page 625 (1972 - Englert)
"T" iron
T.P. - NE 45.29'
P.P. - SSE 95.16'
P.P. - SW 40.98'
- L.C.R.C. rec. in Liber 5, Page 110 (1984 - Rosema)
C.I. mon.
nail in NW side Power pole - ESE 95.07'
PK nail in SE side Power pole - SSW 120.03'
C.I. mon. (center of section) - N 2683.70'
At centerline of gravel roads N-S-E-W

B. Description of corner evidence found and/or method applied in restoring or reestablishing corner:


- B-7
Found C.I. mon. (top broken) 0.2' below grade
Found nail in NW side Power pole - ESE 95.21'
Found PK nail in SE side Power pole - SW 120.11'
At centerline of gravel roads N-S-E-W

10/19/98
[Signature]

I hereby accept the C.I. mon. as a careful and faithful perpetuation of the position of the original corner.

C. Description of monument for corner and accessories established to perpetuate locating the position of the corner:

- B-7
C.I. mon.
Set nail and remon. tag in N side of Power pole - S73°E 95.57'
Set nail and remon. tag in NE side 8" Elm (5' above grd) - S39°E 113.37'
Set nail and remon. tag in SE side Power pole - S26°W 120.11'
Set nail and remon. tag in NE side Power pole (3' above grd) - N31°W 119.93'
Set nail and remon. tag in E side 3" Maple - N25°E 78.02'
At centerline of gravel roads N-S-E-W

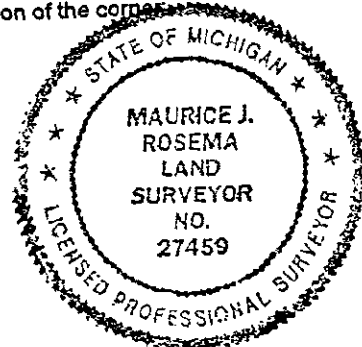

\$9.00 CORNER
Receipt #18213
\$1.00 PHOTO
Receipt #18213

Signed by *Maurice J. Rosema*
Surveyor's Michigan License No. 27459

Date Oct. 17, 1998