

# SURVEY & REMONUMENTATION

FEB 27 1998

## SECTION

### Ottawa County Remonumentation LAND CORNER RECORDATION CERTIFICATE Filing Requirement of Act 74, Mich. P.A. 1970

For corners in

<u>Ottawa</u> (County)	Located In:	Corner Code #
1. Public Land Survey	T <u>7N</u> R <u>14W</u>	B-11 _____ N 1/4 cor. Sec. 31
	T _____ R _____	_____
	T _____ R _____	_____
	T _____ R _____	_____
2. Property Controlling in Section	S _____ T _____ R _____	_____
	S _____ T _____ R _____	_____
3. Miscellaneous Property in Sec.	S _____ T _____ R _____	_____
	S _____ T _____ R _____	_____

RECORDED

97 DEC -8 AM 11:29

*Gary K. Hallett*  
REGISTER OF DEEDS  
OTTAWA COUNTY, MI

Register of Deeds Stamp & File Number

4. Lot No. \_\_\_\_\_, Recorded Plat \_\_\_\_\_  
5. Private Claims \_\_\_\_\_

I, Maurice J. Rosema, in a field survey on Nov. 27 97, 19\_\_\_\_ do hereby state that under requirements of P.A. 74, Michigan P.A. of 1970, the corner points mentioned in lines 1 and 2 above were in conformance with regulations and rules therefore as required in the current manual of survey instructions of the United States Department of the Interior, Bureau of Land Management or by a decree of a Court of Law and /or that the corner points mentioned in lines 3, 4 and 5 above were in conformance with the rules of the Michigan Board of Land Surveyors or by a Decree of a Court of Law; established, re-established, monumented, recovered, found as expressed below:

NOTE: Not more than 2 corners, all in the same town and range, may be recorded on this certificate.

A	B	C	D	E	F	G	H	I	J	K	L	M
	6	5	4	3	2	1						
3												
4	7	8	9	10	11	12						
5												
6	16	17	16	15	14	13						
7												
8	19	20	21	22	23	24						
9												
10	30	29	28	27	26	25						
11	•											
12	31	32	33	34	35	36						
13												

A. Description of original monument and accessories and/or subsequent restoration:

B-11  
GLO.- Britian 1832 LCRC per L. 2, P. 565 (1974)  
post CI mon.  
12" Beech - P pole - N25°E 89.53'  
N61°W 15 lks SE house corner - N20°W 67.43'  
10" Beech - T pole - S45°W 44.39'  
S67°E 26 lks NE house corner - S40°W 104.63'

B. Description of corner evidence found and/or method applied in restoring or reestablishing corner:


B-11  
Found C.I. monument in mon. box  
SE house corner (foundation) - NW 67.51'  
NE house corner (foundation) - SW 104.80'

P.A. 345 OTTAWA COUNTY  
PEER APPROVED 12-1-97  
*G.D.N.*

I hereby accept this corner as a correct and accurate perpetuation of the position of the original corner.

C. Description of monument for corner and accessories established to perpetuate locating the position of the corner:

B-11  
C.I. monument in mon. box  
On centerline bit. conc. roads E, W and S, On centerline of gravel road N  
SE house corner (foundation) - N55°W 67.51'  
NW corner of brick house - S50°E 126.97'  
Set nail and remon. tag in SE side Pole - N49°E 43.59'  
NE corner of house (foundation) - S52°W 104.80'

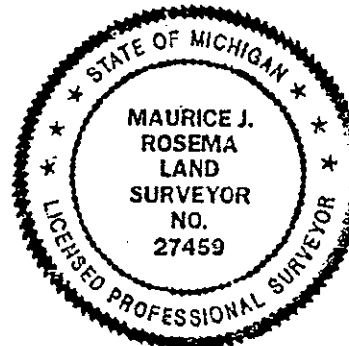

\$ 5.00 CORNER  
\$ 1.00 PHOTO

Signed by *Maurice J. Rosema*  
Surveyor's Michigan License No. 27459

Date 12/01/97