

SURVEY & REMONUMENTATION

DEC 01 1998

Ottawa County Remonumentation

LAND CORNER RECORDATION CERTIFICATE
Filing Requirement of Act 74, Mich. P.A. 1970

SECTION

For corners in Ottawa

Located In: Corner Code #
 7N 14W C-1
 T ___ R ___ NW cor. Sec. 5
 T ___ R ___ Polkton Twp
T8N R14W C-13
 T ___ R ___
 S ___ T ___ R ___
 S ___ T ___ R ___
 S ___ T ___ R ___
 S ___ T ___ R ___

RECORDED
98 JUL 24 PM 1:47

Ray Schultz
REGISTER OF DEEDS
OTTAWA COUNTY, MI

Register of Deeds Stamp & File Number

1. Public Land Survey

2. Property Controlling in Section

3. Miscellaneous Property in Sec.

4. Lot No. _____, Recorded Plat _____
 5. Private Claims _____

I, Maurice J. Rosema, in a field survey on Jan. 28, 1998 do hereby state that under requirements of P.A. 74, Michigan P.A. of 1970, the corner points mentioned in lines 1 and 2 above were in conformance with regulations and rules therefore as required in the current manual of survey instructions of the United States Department of the Interior, Bureau of Land Management or by a decree of a Court of Law and /or that the corner points mentioned in lines 3, 4 and 5 above were in conformance with the rules of the Michigan Board of Land Surveyors or by a Decree of a Court of Law, established, re-established, monumented, recovered, found as expressed below:

NOTE: Not more than 2 corners, all in the same town and range, may be recorded on this certificate.

	A	B	C	D	E	F	G	H	I	J	K	L	M
1													
2	6		5		4		3		2		1		
3													
4	7		8		9		10		11		12		
5													
6	18		17		16		15		14		13		
7													
8	19		20		21		22		23		24		
9													
10	30		29		28		27		26		25		
11													
12	31		32		33		34		35		36		
13													

A. Description of original monument and accessories and/or subsequent restoration:

C-1
 GLO survey notes - 1837 by surveyor Mullett post
 10" Hemlock - S17°E 9 links
 LCRC rec. in Liber 3, Page 134 (1976 by Englert)
 3/4" pipe
 power pole - W 93.11'
 14" Maple - SE 96.40'
 40" Oak - SSW 192.87'
 LCRC rec. in Liber 4, Page 7 (1980 by Joiner)
 C.I. mon.
 power pole - W 93.11'
 14" Maple - SE 96.40'
 40" Oak - SSW 192.87'

LCRC rec. in Liber 2, Page 605 (1997 by Vugteveen) - over (rec. as C-13, T8N, R14W)

B. Description of corner evidence found and/or method applied in restoring or reestablishing corner:


C-1
 Found C.I. mon. in mon. box 0.4' below road surface
 Found nail and remon. tag in E side 12" Oak - SSE 91.09'
 Found nail and remon. tag in N side power pole - ESE 37.56'
 Found nail and remon. tag in top of wood post - NE 39.85'
 Found nail and remon. tag in N side of power pole W 34.00'
 Found x cut in top N side conc. culvert - WSW 27.09'
 Found nail and tag in E side 12" Oak - SSE 91.00'
 Found nail and tag in S side power pole - ESE 37.61'

I hereby accept the position of the C.I. mon. as a careful perpetuation of the position of the original corner.

C. Description of monument for corner and accessories established to perpetuate locating the position of the corner:

C-1
 C.I. mon. in mon. box
 Found nail and remon. tag in E side 12" Oak - S24°E 91.00'
 Found nail and remon. tag in power pole - S65°E 37.56'
 Found nail and remon. tag in top of wood post - N58°E 39.85'
 Found nail and remon. tag in N side power pole - N86°W 34.00'
 Found x cut in top N side conc. culvert - S74°W 27.09'
 This corner is common with C-13, T8N, R14W
 Centerline of N-S bit. conc. road - E 1.5'

PAID BY OTTAWA COUNTY
 FIELD APPROVED 6-15-98

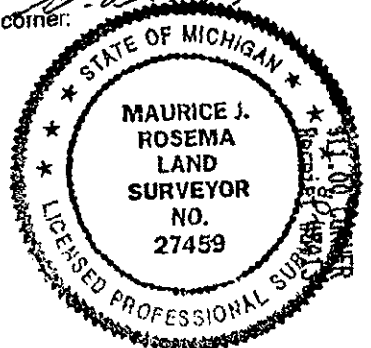

Signed by Maurice J. Rosema
 Surveyor's Michigan License No. 27459

Date June 13, 1998

SURVEY &
REMONUMENTATION

DEC 01 1998

SECTION

LCRC per Liber 2, Page 605 (recorded as C-13, T8N, R14W)
C.I. mon.

nail and OC remon. tag in N side power pole - AZ $110^{\circ} 37.60'$

nail and OC remon. tag in N side power pole - AZ $270^{\circ} 33.93'$

nail and OC remon. tag in SW side 10" Oak - AZ $151^{\circ} 90.90'$

nail and OC remon. tag in top of wood post - AZ $54^{\circ} 39.82'$

x cut in top of N end conc. culv. - AZ $249^{\circ} 27.11'$

Centerline of N-S road - E 1.5'
on centerline of fence row to W

