

Ottawa County Remonumentation
LAND CORNER RECORDATION CERTIFICATE
 Filing Requirement of Act 74, Mich. P.A. 1970

For corners in
Ottawa
 (County)

Located In: Corner Code #

- | | | | | | |
|------------------------------------|---|------------|---|-------------|---------------|
| 1. Public Land Survey | T | <u>T7N</u> | R | <u>R14W</u> | C-3 |
| | T | | R | | (SE cor of |
| | T | | R | | Section 6) |
| | T | | R | | Allendale Twp |
| 2. Property Controlling in Section | S | | T | | |
| | S | | T | | |
| 3. Miscellaneous Property in Sec. | S | | T | | |
| | S | | T | | |

RECORDED

95 NOV 15 PM 2:10

Rhonda Kellman
 REGISTER OF DEEDS
 OTTAWA COUNTY, MI

Register of Deeds Stamp & File Number

4. Lot No. _____, Recorded Plat _____
 5. Private Claims _____

| A | B | C | D | E | F | G | H | I | J | K | L | A |
|----|----|----|----|----|----|----|---|---|---|---|---|---|
| 2 | 6 | 5 | 4 | 3 | 2 | 1 | | | | | | |
| 3 | | ● | | | | | | | | | | |
| 4 | 7 | 8 | 9 | 10 | 11 | 12 | | | | | | |
| 5 | | | | | | | | | | | | |
| 6 | 13 | 17 | 16 | 15 | 14 | 13 | | | | | | |
| 7 | | | | | | | | | | | | |
| 8 | 19 | 20 | 21 | 22 | 23 | 24 | | | | | | |
| 9 | | | | | | | | | | | | |
| 10 | 30 | 29 | 28 | 27 | 26 | 25 | | | | | | |
| 11 | | | | | | | | | | | | |
| 12 | 31 | 32 | 33 | 34 | 35 | 36 | | | | | | |
| 13 | | | | | | | | | | | | |

I, Maurice J. Rosema, in a field survey on Jan. 24, 19 95
do hereby certify that under requirements of P.A. 74, Michigan P.A. of 1970, the corner points mentioned in lines 1 and 2 above were in conformance with regulations and rules therefore as required in the current manual of survey instructions of the United States Department of the Interior, Bureau of Land Management or by a decree of a Court of Law and/or that the corner points mentioned in lines 3, 4 and 5 above were in conformance with the rules of the Michigan Board of Land Surveyors or by a Decree of a Court of Law; established, re-established, monumented, re-monumented, recovered, found as expressed below:


NOTE: Not more than 4 corners, all in the same town and range, may be recorded on this certificate.

A_C Description of original monument and accessories and/or subsequent restoration:

- | | | | |
|-----------------------------------|---------------|------------|---|
| Glo - 1832 (Noah Brookfield D.S.) | 14" Sassafras | WSW 42.00' | L.C.R.C. recorded in Liber 5, Page 219 |
| 22" White Oak S53°W 33lks | 18" Sassafras | S 40.00' | July 26, 1985 |
| 14" White Oak N46°E 13 lks | | | C.I. Monument |
| | | | Nail in N side 12" Sassafras - WSW 42.39' |
| L.C.R.C. recorded in Liber 4 | | | Nail in NE side 12" Sassafras - NW 35.75' |
| Page 87 - June 30, 1980 | | | Nail in W side 18" Sassafras - S 40.92' |
| C.I. Monument | | | On tree row to S |
| 12" Sassafras SW 35.50' | | | NW cor. field - N 10' |

- B_{C-3} Description of corner evidence found and/or method applied in restoring or reestablishing corner:
- | | | |
|---------------------|---------|--|
| Found C.I. Monument | | |
| 12" Sassafras | W 42'± | |
| 12" Sassafras | NW 36'± | |
| 19" Sassafras | S 41'± | |

I hereby accept this corner as a correct and accurate perpetuation of the position of the original corner.

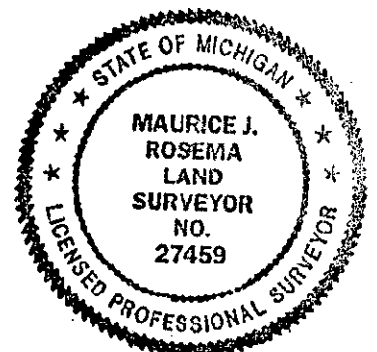

C. Description of monument for corner and accessories established to perpetuate locating the position of the corner:

- C-3
 C.I. Monument
- | | |
|--|--------------|
| Set nail and Ottawa County remon. tag in S side 12" Sassafras | S88°W 42.39' |
| Set nail and Ottawa County remon. tag in E side 19" Sassafras | S10°W 40.87' |
| Set nail and Ottawa County remon. tag in SE side 12" Sassafras | N50°W 35.56' |
| Set nail and Ottawa County remon. tag in W side 7" Maple | N25°E 26.97' |
- On tree row to S

PEER APPROVED 10/23/95

Signed by *Maurice J. Rosema* Date October 21, 1995
 Surveyor's Michigan License No. 27459