SURVEY & REMONUMENTATION

DEC 01 1998

SECTION

OTTAWA COUNTY REMONUMENTATION

LAND CORNER RECORDATION CERTIFICATE
Filing Requirement of Act 74, Mich. P.A. 1970

For corners in OTTAWA (County)

	Located In:	Corner Code #
1. Public Land Survey	T7N R 14W	C-4 (W ¼ corner Section 8) ~~Allendale~~ POLKTON Twp
	T___ R___	
	T___ R___	
	T___ R___	
2. Property Controlling in Section	S___ T___ R___	
	S___ T___ R___	
3. Miscellaneous Property in Sec.	S___ T___ R___	
	S___ T___ R___	

RECORDED
98 SEP 29 PM 1:56
REGISTER OF DEEDS
OTTAWA COUNTY, MI

Register of Deeds Stamp & File Number

4. Lot No. _____, Recorded Plat _____
5. Private Claims _____

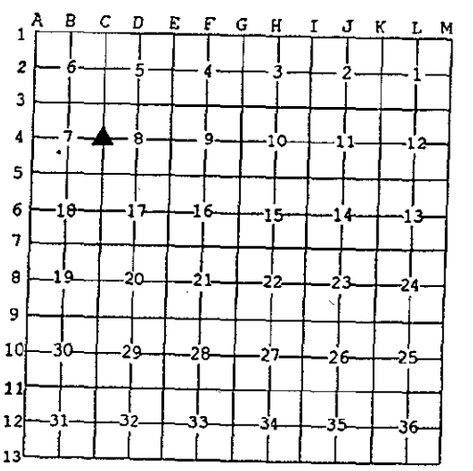

I, Randal J. Vugteveen, in a field survey on March 17, 19 98 do hereby state that under requirements of P.A. 74, Michigan P.A. of 1970, the corner points mentioned in lines 1 and 2 above were in conformance with regulations and rules therefore as required in the current manual of survey instructions of the United States Department of the Interior, Bureau of Land Management or by a decree of a Court of Law and /or that the corner points mentioned in lines 3, 4 and 5 above were in conformance with the rules of the Michigan Board of Land Surveyors or by a Decree of a Court of Law; established, re-established, monumented, recovered, found as expressed below:

NOTE: Not more than 2 corners, all in the same town and range, may be recorded on this certificate.

A. Description of original monument and accessories and/or subsequent *restoration:*

G.L.O. (1837), John Mullett
22"W Oak S53°W 33 links
14"W Oak N46°E 13 links
N. Bank River 3.04 chains

B. Description of corner evidence found and/or method applied in restoring or reestablishing corner:

C-4 Found "L" iron on W. line government Lot 8 on N. bank of Grand River, as shown on Donald Sandel recorded survey Liber 4, Page 292, 293 & 294.

Held 266.63' distance N. per Sandel survey and set corner on straight line to NW corner Section 8.

Set Ottawa County monument, ¾" X 36" Pin with aluminim cap (see sketch included) is accepted as a careful and faithful reestablishment of the position of the original corner.

GDM 4/20/98

C. Description of monument for corner and accessories established to perpetuate locating the position of the corner:

C-4 Ottawa County monument, ¾" X 36" Pin with aluminum cap, (see sketch included).

Nail & Ottawa County Remon. tag in W. side 4" Maple AZ 210° 6.85'
Nail & Ottawa County Remon. tag in W. side Twin 12" Maple AZ 0° 4.97'
Nail & Ottawa County Remon. tag in N. side 14" Maple AZ 295° 76.07'
Nail & Ottawa County Remon. rag in N. side 4" Maple clump AZ 70° 40.43'
"L" iron on N. bank Grand River AZ 180° 266.63'

STATE OF MICHIGAN
RANDAL J. VUGTEVEEN
NO. 28429
LICENSED LAND SURVEYOR
$3.00 CORNER RECORDER

Signed by _____ Date Jul 23, 1998
Surveyor's Michigan License No. 28429

FORM APPROVED BY MICHIGAN STATE BOARD OF PROFESSIONAL SURVEYORS, JAN. 28, 1971
REVISED MAY 14, 1975
REVISED JAN., 1983
REVISED OCT., 1995