

Ottawa County Remonumentation
LAND CORNER RECORDATION CERTIFICATE
 Filing Requirement of Act 74, Mich. P.A. 1970

RECORDED
 96 DEC 18 PM 4:56

For corners in

<u>Ottawa</u> <small>(County)</small>	Located In:	Corner Code #
1. Public Land Survey	T <u>7N</u> R <u>14W</u>	<u>C-7</u> (NW cor.) Sec. 20)
	T _____ R _____	_____
	T _____ R _____	_____
	T _____ R _____	_____
2. Property Controlling in Section	S _____ T _____ R _____	_____
	S _____ T _____ R _____	_____
3. Miscellaneous Property in Sec.	S _____ T _____ R _____	_____
	S _____ T _____ R _____	_____

Polyak's Station
 REGISTER OF DEEDS
 OTTAWA COUNTY, MI

Register of Deeds Stamp & File Number

4. Lot No. _____, Recorded Plat _____
 5. Private Claims _____

A	B	C	D	E	F	G	H	I	J	K	L	M
2	6	5	4	3	2	1						
3												
4	7	8	9	10	11	12						
5												
6	18	17	16	15	14	13						
7												
8	19	20	21	22	23	24						
9												
10	30	29	28	27	26	25						
11												
12	31	32	33	34	35	36						
13												

I, Maurice J. Rosema, in a field survey on Nov. 30, 1996, do hereby certify that under requirements of P.A. 74, Michigan P.A. of 1970, the corner points mentioned in lines 1 and 2 above were in conformance with regulations and rules therefore as required in the current manual of survey instructions of the United States Department of the Interior, Bureau of Land Management or by a decree of a Court of Law and/or that the corner points mentioned in lines 3, 4 and 5 above were in conformance with the rules of the Michigan Board of Land Surveyors or by a Decree of a Court of Law; established, re-established, monumented, re-monumented, recovered, found as expressed below:

NOTE: Not more than 4 corners, all in the same town and range, may be recorded on this certificate.

A. Description of original monument and accessories and/or subsequent restoration:

C-7
 GLO - 1832 by Britian LCRC rec. in L. 5, P 223 (over) LCRC in L 4, P. 124 (over)
 8" Hemlock at sec. cor. LCRC rec. in L 3, P 324 (over) LCRC in L 1, P 101 (over)

B. Description of corner evidence found and/or method applied in restoring or reestablishing corner:

C-7
 Found C.I. monument
 P pole - SE 91'
 36" Maple - NE 66'


P.A. 345 OTTAWA COUNTY
 PEER APPROVED 12-9-96

I hereby accept this corner as a correct and accurate perpetuation of the position of the original corner.

M. J. Rosema

C. Description of monument for corner and accessories established to perpetuate locating the position of the corner:

C-7
 C.I. monument
 At centerline "X" of gravel roads E-W-S 0.5' below grade
 Nail and remon. tag in S side wood post - S57°W 49.95'
 Nail and remon. tag in S side 24" Beech - N70°W 120.06'
 Nail and remon. tag in N side P pole - S62°E 91.01'
 Nail and remon. tag in S side 36" Maple - N62°E 66.19'
 Nail and remon. tag in W side 20" Mulberry - N3°E 56.48'

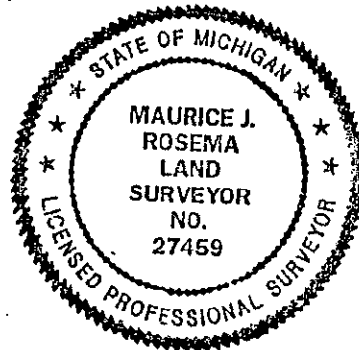

Signed by *M. J. Rosema* Date Dec. 9, 1996
 Surveyor's Michigan License No. 27459

LCRC rec. in L. 5, P. 223
(1985)

C.I. monument

Nail and tag in S side 36" Beech - WNW 63.90'

Nail in SE side 36" Maple - NE 66.15'

Nail and tag in N side P pole - ESE 91.10'

Nail in SE side T pole - SW 50.00'

LCRC rec. in L. 4, P. 124
(1980)

C.I. monument

42" Beech - NW 63.89'

T pole - SW 49.93'

36" Maple - NE 66.20'

P pole - Se 90.66'

LCRC rec. in L. 3, P 324
(1979)

Iron bar

38" Beech - NW 61.81'

38" Maple - NE 64.85'

P pole - SE 90.86'

c/l st. sign - SW 48.84'

LCRC rec. in L. 1, P. 101
(1971)

Iron bar

c/l st sign - N 22.19'

Nail in fc. of 38" Beech - NW 61.81'

Nail in fc. of 38" Maple - NE 64.85'

Nail in fc. of P pole - SE 90.86'

Nail in fc. of T pole - SE 50.63'