

APR 05 1996

Ottawa County Remonumentation
LAND CORNER RECORDATION CERTIFICATE
Filing Requirement of Act 74, Mich. P.A. 1970

RECORDED

95 DEC 12 PM 4:53

For corners in COMMISSION

Ottawa (County)	Located In:	Corner Code #
1. Public Land Survey	T <u>T7N</u> R <u>R14W</u>	C-10
	T _____ R _____	_____
	T _____ R _____	_____
	T _____ R _____	_____
2. Property Controlling in Section	S _____ T _____ R _____	_____
	S _____ T _____ R _____	_____
3. Miscellaneous Property in Sec.	S _____ T _____ R _____	_____
	S _____ T _____ R _____	_____
4. Lot No. _____, Recorded Plat _____		
5. Private Claims _____		

Richard Chittman
REGISTER OF DEEDS
OTTAWA COUNTY, MI

Register of Deeds Stamp & File Number

Maurice J. Rosema, in a field survey on Sept. 6, 1995, do hereby certify that under requirements of P.A. 74, Michigan P.A. of 1970, the corner points mentioned in lines 1 and 2 above were in conformance with regulations and rules therefore as required in the current manual of survey instructions of the United States Department of the Interior, Bureau of Land Management or by a decree of a Court of Law and/or that the corner points mentioned in lines 3, 4 and 5 above were in conformance with the rules of the Michigan Board of Land Surveyors or by a Decree of a Court of Law; established, re-established, monumented, re-monumented, recovered, found as expressed below:

A	B	C	D	E	F	G	H	I	J	K	L	M
2	6	5	4	3	2	1						
3												
4	7	8	9	10	11	12						
5												
6	18	17	16	15	14	13						
7												
8	19	20	21	22	23	24						
9												
10	30	29	28	27	26	25						
11												
12	31	32	33	34	35	36						
13												

NOTE: Not more than 4 corners, all in the same town and range, may be recorded on this certificate.

A. Description of original monument and accessories and/or subsequent restoration:
C-10

GLO - 1832 by Noah Brookfield
for Calvin Britain D.S.
Set 10" Hemlock is Sec. cor.

L.C.R.C. recorded in Liber
2, Page 656 - Sept. 20, 1974
(over)

L.C.R.C. recorded in Liber
5, Page 225 - Sept. 5, 1985
(over)

L.C.R.C. recorded in Liber
5, Page 76 - Dec. 20, 1983
(over)

C-10
B. Description of corner evidence found and/or method applied in restoring or reestablishing corner:

Found C.I. mon. with broken top 0.2' below grade of gravel road
Found PK nail in NW side P pole NNE 164.14'
Found PK nail in E side P pole NNW 151.36'
SE cor. brick garage NNW 180.67'

P.A. 345 OTTAWA COUNTY
PEER APPROVED 12/11/95


I hereby accept this corner as a correct and accurate perpetuation of the position of the original corner.

Murray P. Newbold
MDN

C. Description of monument for corner and accessories established to perpetuate locating the position of the corner:

C-10
C.I. mon.
Set nail and O.C. tag in NW side P pole
Set nail and O.C. tag in E side P pole
Set nail and O.C. tag in S side 4" W Cherry
SE cor. brick garage
On centerline N-S gravel road

N22°E 164.14'
N9°W 151.36'
N81°W 48.18'
N28°W 180.67'

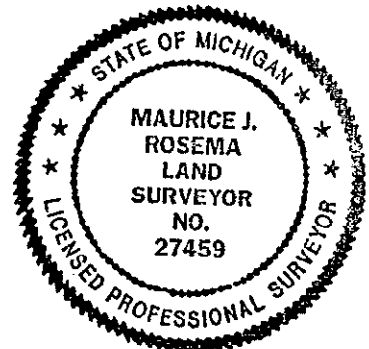

Signed by *Maurice J. Rosema*
Surveyor's Michigan License No. 27459

Date Oct. 21, 1995

C-10 T7N, R14W

L.C.R.C. recorded in Liber 2, Page 565
- September 20, 1974

Iron over Stone

Tele Pole	S75°W 25.85'
P.pole	N20°E 163.88'
P.pole	N20°W 150.95'
Se cor attached garage	N45°W 180.74'

L.C.R.C. recorded in Liber 5, Page 76
- December 20, 1983

C.I. Monument

PP	NE 163.88'
PP	NW 150.95'
Twin Elm	W 74.43'
SE cor of garage	NW 180.74'

L.C.R.C. recorded in Liber 5, Page 225
- September 5, 1985

C.I. Monument

PK in W side P.P.	NE 164.13'
Nail in N side 4" Tw. Elm	W 74.40'
SE cor brick gar.	NW 180.68'
Nail in E side P.P.	NNW 151.28'