

SURVEY & DOCUMENTATION Ottawa County Remonumentation

RECORDED

APR 24 1995

LAND CORNER RECORDATION CERTIFICATE
Filing Requirement of Act 74, Mich. P.A. 1970

94 DEC 15 AM 11:51

For corners in **COMMISSION**

Deborah S. Holman
REGISTER OF DEEDS
OTTAWA COUNTY, MI

Ottawa (County) Located In: _____ Corner Code # _____

1. Public Land Survey T 7N R 14W C-13
 T _____ R _____
 T _____ R _____
 T _____ R _____

2. Property Controlling S _____ T _____ R _____
 in Section S _____ T _____ R _____

3. Miscellaneous S _____ T _____ R _____
 Property in Sec. S _____ T _____ R _____

Register of Deeds Stamp & File Number

4. Lot No. _____, Recorded Plat _____
 5. Private Claims _____

	A	B	C	D	E	F	G	H	I	J	K	L	M
2	6	5	4	3	2	1							
3													
4	7	8	9	10	11	12							
5													
6	18	17	16	15	14	13							
7													
8	19	20	21	22	23	24							
9													
10	30	29	28	27	26	25							
11													
12	31	32	33	34	35	36							
13													

Maurice J. Rosema Jan. 2 94

I, _____, in a field survey on _____, 19 _____, do hereby certify that under requirements of P.A. 74, Michigan P.A. of 1970, the corner points mentioned in lines 1 and 2 above were in conformance with regulations and rules therefore as required in the current manual of survey instructions of the United States Department of the Interior, Bureau of Land Management or by a decree of a Court of Law and/or that the corner points mentioned in lines 3, 4 and 5 above were in conformance with the rules of the Michigan Board of Land Surveyors or by a Decree of a Court of Law; established, re-established, monumented, re-monumented, recovered, found as expressed below:

NOTE: Not more than 4 corners, all in the same town and range, may be recorded on this certificate.

A. Description of original monument and accessories and/or subsequent restoration:

- C-13
 GLO - (no date) by Greer - 1974 per L.C.R.C. Joiner - 1980 per L.C.R.C.
 Loucius Lyon D.S. rec. in L. 2, P. 583 rec. in L. 4, P. 137
 30" B. Oak at (over) (over)
 Sec. cor.
 Rosema - 1988 per L.C.R.C. Milliron - 1991 per L.C.R.C.
 rec. in L. 5, P. 338 rec. in L. 6, P. 130
 (over) (over)

B. Description of corner evidence found and/or method applied in restoring or reestablishing corner:


- C-13
 Found C.I. mon. in mon. box
 SW. cor. house foundation - N44° E 125.35'
 Found spike in SW. root of 36" W. Cherry - N55° W 53.47'
 Found spike in S. root of 19" tw. Oak - N74° W 102.59'

PA. 345 OTTAWA COUNTY

PEER APPROVED 4/18/94

Murray D. Nedwell

I hereby accept this corner as a correct and accurate perpetuation of the position of the original corner.

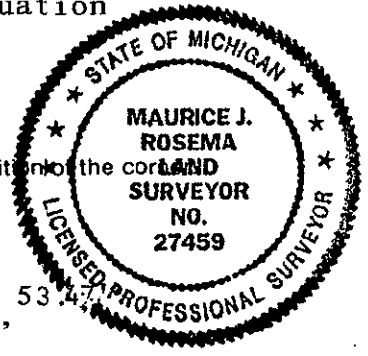

- C. Description of monument for corner and accessories established to perpetuate locating the position of the corner:
- C-13
 C.I. mon. in mon. box
 Set nail and remon. tag in SW. root of 36" W. Cherry - N55° W 53.47'
 Set nail and remon. tag in SE. side Power pole - N65° E 56.60'
 Set nail and remon. tag in S. root of 19" tw. Oak - N74° W 102.59'
 Street sign post - S70° W 83.10'
 On centerline of E.-W. bit. conc. road
 Centerline of gravel road to S. - W. 40'

Signed by *Maurice J. Rosema* Date April 18, 1994
 Surveyor's Michigan License No. 27459

Part A - continued

Greer - 1974 per L.C.R.C. rec. in L. 2, P. 583

Angle iron

On fence line to North

6" Cherry - N. 22.11'

Power pole - N70° E 56.08'

36" Cherry - N60° W 50.82'

SW. corner house - N40° E 125.39'

Joiner - 1980 per L.C.R.C. rec. in L. 4, P. 137

C.I. mon.

Power pole - NE. 56.07'

Telephone pole - S. 38.45'

37" Blace Cherry - NW. 50.71'

Tw. 18" Oak - WNW. 102.55'

Blendon corner - W. 42.23'

Rosema - 1988 per L.C.R.C. rec. in L. 5, P. 338

C.I. mon.

Nail and S. side Power pole - NE. 56.60'

Nail in SW. root of 30" Cherry - NW. 53.47'

Centerline of road to S. - W. 40'

Centerline of E.-W. road - S. 4'

SW. corner house foundation - NE. 125.39'

Milliron - 1991 per L.C.R.C. rec. in L. 6, P. 130

C.I. mon.

Blendon corner - W. 42.20'

Nail in SW. root 30" W. Cherry - NW. 53.50'

Nail in W. side post - N. 33.77'

Nail in S. side Power pole - NE. 56.55'

Nail in W. side post - SSW. 38.77'

4392

