

**SURVEY &
REMONUMENTATION**

DEC 01 1998

SECTION

Ottawa County Remonumentation
LAND CORNER RECORDATION CERTIFICATE
Filing Requirement of Act 74, Mich. P.A. 1970

For corners in

<u>Ottawa</u> <small>(County)</small>	Located In:	Corner Code #
1. Public Land Survey	T <u>7N</u> R <u>14W</u>	<u>D-1</u>
	T _____ R _____	<u>N 1/4, cor. Sec. 5</u>
	T _____ R _____	<u>Polkton Twp</u>
	T <u>8N</u> R <u>14W</u>	<u>D-13</u>
2. Property Controlling in Section	S _____ T _____ R _____	_____
	S _____ T _____ R _____	_____
3. Miscellaneous Property in Sec.	S _____ T _____ R _____	_____
	S _____ T _____ R _____	_____

RECORDED
98 JUL 24 PM 1:47
[Signature]
REGISTER OF DEEDS
OTTAWA COUNTY, MI
Register of Deeds Stamp & File Number

4. Lot No. _____, Recorded Plat _____
5. Private Claims _____

I, Maurice J. Rosema, in a field survey on Jan. 28, 1998 do hereby state that under requirements of P.A. 74, Michigan P.A. of 1970, the corner points mentioned in lines 1 and 2 above were in conformance with regulations and rules therefore as required in the current manual of survey instructions of the United States Department of the Interior, Bureau of Land Management or by a decree of a Court of Law and/or that the corner points mentioned in lines 3, 4 and 5 above were in conformance with the rules of the Michigan Board of Land Surveyors or by a Decree of a Court of Law; established, re-established, monumented, recovered, found as expressed below:

NOTE: Not more than 2 corners, all in the same town and range, may be recorded on this certificate.

A	B	C	D	E	F	G	H	I	J	K	L	M
1												
2	6		5		4		3		2		1	
3												
4	7		8		9		10		11		12	
5												
6	10		17		16		15		14		13	
7												
8	19		20		21		22		23		24	
9												
10	30		29		28		27		26		25	
11												
12	31		32		33		34		35		36	
13												

A. Description of original monument and accessories and/or subsequent restoration:

D-1 This corner was not set by GLO LCRC rec. in Liber 4, Page 126 (1980 by Joiner) C.I. mon. (rec. as D-13, T8N, R14W) power pole - SE 48.56' telephone pole - NE 46.27' 22" Maple - SW 48.76' 14" Maple - NW 57.30'	LCRC rec. in Liber 2, Page 177 (1973 by Spicer) 1" Iron CP-MBT pole - N75 W 35.98' 14" W Cherry - S80 W 23.94' centerline of N-S road - E 3' 1" iron - W 33'	LCRC rec. in Liber 3, Page 675 (1997 by Vugteveen) (rec. as D-13, T8N, R14W) - over
--	---	---

B. Description of corner evidence found and/or method applied in restoring or reestablishing corner:


B-1
Found C.I. mon. in mon. box 1.5' below grade
Found PK nail in SW side power pole - SE 48.46'
Found nail and remon. tag in SW side power pole SE 48.56'
Found nail and remon. tag in SE side power pole - SW 42.81'
Found nail and remon. tag in N side 13" oak - W 42.00'

I hereby accept the C.I. mon. as the position of the corner.

C. Description of monument for corner and accessories established to perpetuate locating the position of the corner:

D-1
C.I. mon. in mon. box
Found nail and remon. tag in SW side power pole - S38°E 48.56'
Found nail and remon. tag in SE side power pole - S37°W 42.81'
Found nail and remon. tag in N side 13" Oak - N85°W 42.00'
Center of base of street sign - N46°E 47.55'
On centerline of N-S bit. conc. road, on centerline of gravel road to E
This corner is common with D-13, T8N, R14W

PA. 345 OTTAWA COUNTY
RECORD APPROVED 6-15-98
[Signature]

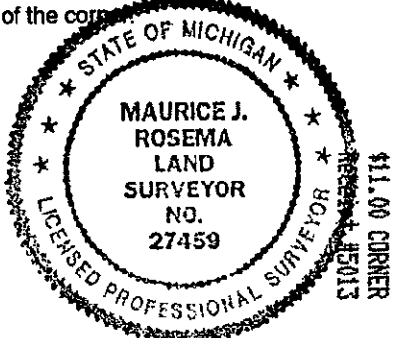

Signed by *[Signature]*
Surveyor's Michigan License No. 27459

Date June 13, 1998

SURVEY &
REMONUMENTATION

DEC 01 1998

SECTION

LCRC per Liber 3, Page 675 (recorded as D-13, T8N, R14W)

C.I. mon. in mon. box

nail and OC remon. tag in N side 15' Oak - AZ 272° 41.99'

nail and OC remon. tag in SE side utility pole - AZ 214° 42.85'

nail and OC remon. tag in SW side power pole - AZ 137° 48.58'

nail and OC remon. tag in Se side power pole - AZ 11° 171.77'

x cut in top of N end conc. culv. - AZ 249° 27.11'

On centerline of tree row to W

At centerline of intersection of roads

