

APR 05 1996

COMMISSION

Ottawa County Remonumentation
 LAND CORNER RECORDATION CERTIFICATE
 Filing Requirement of Act 74, Mich. P.A. 1970

RECORDED

DEC 12 PM 4: 51

S. J. ...
 REGISTER OF DEEDS
 OTTAWA COUNTY, MI


For corners in

Ottawa (County)	Located In:	Corner Code #
1. Public Land Survey	T <u>T7N</u> R <u>R14W</u>	D-3
	T _____ R _____	_____
	T _____ R _____	_____
	T _____ R _____	_____
2. Property Controlling in Section	S _____ T _____ R _____	_____
	S _____ T _____ R _____	_____
3. Miscellaneous Property in Sec.	S _____ T _____ R _____	_____
	S _____ T _____ R _____	_____

Register of Deeds Stamp & File Number

4. Lot No. _____, Recorded Plat _____
 5. Private Claims _____

I, Maurice J. Rosema, in a field survey on Jan. 20, 1995, do hereby certify that under requirements of P.A. 74, Michigan P.A. of 1970, the corner points mentioned in lines 1 and 2 above were in conformance with regulations and rules therefore as required in the current manual of survey instructions of the United States Department of the Interior, Bureau of Land Management or by a decree of a Court of Law and/or that the corner points mentioned in lines 3, 4 and 5 above were in conformance with the rules of the Michigan Board of Land Surveyors or by a Decree of a Court of Law; established, re-established, monumented, re-monumented, recovered, found as expressed below:

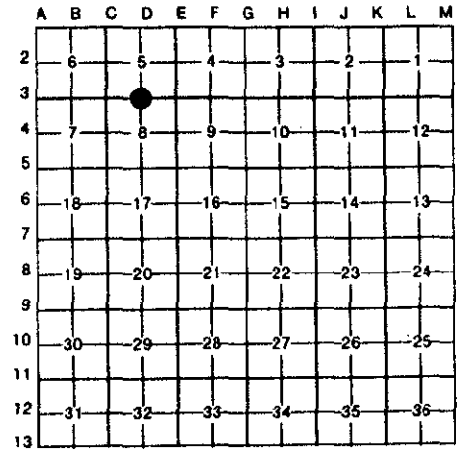

NOTE: Not more than 4 corners, all in the same town and range, may be recorded on this certificate.

A. Description of original monument and accessories and/or subsequent restoration:

D-3
 GLO - 1837 by John Mullett D.S. L.C.R.C. recorded in Liber 3, Page 345 - Jan. 2, 1979
 C.I. mon.
 Set post Nail in SW side tw red Pine S35°E 56.77'
 12" Pine S32°E 13 lks. Nail in S side P pole N83°W 69.98'
 9" Hemlock N57°W 14 lks. Nail in NW side 10" Cherry N38°E 47.99'

B. Description of corner evidence found and/or method applied in restoring or reestablishing corner:

D-3
 Found C.I. mon. in centerline of N-S bit. conc. road
 Found nail in SW side 8" tw Pine SE 56.73'
 Found nail in N side P pole W 69.85'

P.A. 345 OTTAWA COUNTY
 PEER APPROVED 12/11/95

Maurice J. Rosema
 M.J.R.

I hereby accept this corner as a correct and accurate perpetuation of the position of the original corner.

C. Description of monument for corner and accessories established to perpetuate locating the position of the corner:

D-3
 C.I. mon.
 Set nail and O.C. tag in N side P pole N83°W 56.73'
 Set nail and O.C. tag in SW side 8" tw Pine N36°E 56.73'
 Set nail and O.C. tag in S side 4" Sassafrass N59°E 39.12'
 Set nail and O.C. tag in NE side 5" Oak N16°W 67.32'



Signed by Maurice J. Rosema
 Surveyor's Michigan License No. 27459

Date October 21, 1995