

Ottawa County Remonumentation
LAND CORNER RECORDATION CERTIFICATE
 Filing Requirement of Act 74, Mich. P.A. 1970

RECORDED

96 DEC 18 PM 4:5

R. J. Rosema
 REGISTER OF DEEDS
 OTTAWA COUNTY, MI


For corners in

<u>Ottawa</u> (County)	Located In:	Corner Code #
1. Public Land Survey	T 7N R 14W	D-5
	T _____ R _____	(N $\frac{1}{2}$ cor.)
	T _____ R _____	Sec. 17)
	T _____ R _____	
2. Property Controlling in Section	S _____ T _____ R _____	
	S _____ T _____ R _____	
3. Miscellaneous Property in Sec.	S _____ T _____ R _____	
	S _____ T _____ R _____	

Register of Deeds Stamp & File Number

4. Lot No. _____, Recorded Plat _____
 5. Private Claims _____

I, Maurice J. Rosema, in a field survey on Dec. 9, 19 96, do hereby certify that under requirements of P.A. 74, Michigan P.A. of 1970, the corner points mentioned in lines 1 and 2 above were in conformance with regulations and rules therefore as required in the current manual of survey instructions of the United States Department of the Interior, Bureau of Land Management or by a decree of a Court of Law and/or that the corner points mentioned in lines 3, 4 and 5 above were in conformance with the rules of the Michigan Board of Land Surveyors or by a Decree of a Court of Law; established, re-established, monumented, re-monumented, recovered, found as expressed below:

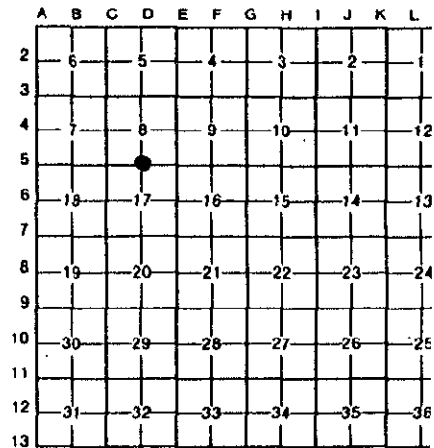

NOTE: Not more than 4 corners, all in the same town and range, may be recorded on this certificate.

A. Description of original monument and accessories and/or subsequent restoration:

D-5		
GLO - 1832 by Britain	LCRC rec. in L. 1, P. 101	LCRC rec. in L. 5, P. 89
8" Swamp Ash at Sec.	Iron pipe	C.I. monument
Cor.	Nail in face of 10" Ash - W 12.60'	10" Ash - W 12.63'
	Nail in face of 18" Maple - NW 18.38'	18" Maple - NW 18.83'
(OVER)	Nail in face of 28" Oak - N 73.48'	28" Oak - N 73.48'
	Nail in face of 10" Ash - SE 19.97	10" Ash - SE 19.97'

B. Description of corner evidence found and/or method applied in restoring or reestablishing corner:

D-5
 Found C.I. monument (top broken)
 Found nail in N side 14" Ash - WNW 13.28'
 Found nail in N side 9" Ash - SW 34.74'
 Found nail in W side 12" Ash - S 20.49'
 Found nail in S side 6" Ash - ESE 30.56'


P.A. 345 OTTAWA COUNTY
 PEER APPROVED 12-9-96

M. J. Rosema

I hereby accept this corner as a correct and accurate perpetuation on the position of the original corner.

C. Description of monument for corner and accessories established to perpetuate locating the position of the corner:

D-5
 C.I. monument
 Nail and remon. tag in W side 18" Maple - N8°W 19.01'
 Nail and remon. tag in N side 14" Ash - N70°W 13.28'
 Nail and remon. tag in N side 9" Ash - S55°W 34.74'
 Nail and remon. tag in W side 12" Ash - S5°E 20.49'
 Nail and remon. tag in S side 6" Ash - S65°E 30.56'
 On W edge of field to S ±

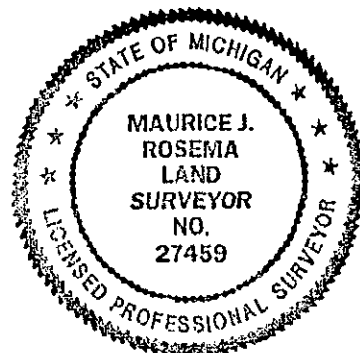

Signed by *M. J. Rosema* Date Dec. 9, 1996
 Surveyor's Michigan License No. 27459

Information from the files of Tru-Line Surveying P.C.

C.I. monument

Nail and tag in W side 18" Maple - N 19.04'

Nail and tag in N side 8" Ash - SW 34.72'

Nail and tag in W side 12" Ash - S 20.47'

Nail and tag in S side 6" Ash - ESE 30.50'

Nail and tag in NE side 12" Ash - WNW 13.29'