

**SURVEY & REMONUMENTATION**

DEC 01 1998

Ottawa County Remonumentation

**SECTION**

**LAND CORNER RECORDATION CERTIFICATE**  
Filing Requirement of Act 74, Mich. P.A. 1970

For corners in

Ottawa <small>(County)</small>	Located In:	Corner Code #
1. Public Land Survey	T <u>7N</u> R <u>14W</u>	<u>E-5</u>
	T <u>    </u> R <u>    </u>	<u>NW cor. Sec. 16</u>
	T <u>    </u> R <u>    </u>	<u>Allendale Twp</u>
	T <u>    </u> R <u>    </u>	<u>    </u>
2. Property Controlling in Section	S <u>    </u> T <u>    </u> R <u>    </u>	<u>    </u>
	S <u>    </u> T <u>    </u> R <u>    </u>	<u>    </u>
3. Miscellaneous Property in Sec.	S <u>    </u> T <u>    </u> R <u>    </u>	<u>    </u>
	S <u>    </u> T <u>    </u> R <u>    </u>	<u>    </u>

**RECORDED**  
98 JUL 24 PM 1:45

*Sam Hubbert*  
REGISTER OF DEEDS  
OTTAWA COUNTY, MI

Register of Deeds Stamp & File Number

4. Lot No. \_\_\_\_\_, Recorded Plat \_\_\_\_\_  
5. Private Claims \_\_\_\_\_

Maurice J. Rosema in a field survey on June 13, 1998 do hereby state that under requirements of P.A. 74, Michigan P.A. of 1970, the corner points mentioned in lines 1 and 2 above were in conformance with regulations and rules therefore as required in the current manual of survey instructions of the United States Department of the Interior, Bureau of Land Management or by a decree of a Court of Law and /or that the corner points mentioned in lines 3, 4 and 5 above were in conformance with the rules of the Michigan Board of Land Surveyors or by a Decree of a Court of Law; established, re-established, monumented, recovered, found as expressed below:

NOTE: Not more than 2 corners, all in the same town and range, may be recorded on this certificate.

	A	B	C	D	E	F	G	H	I	J	K	L	M
1													
2	6		5		4		3		2		1		
3													
4	7		8		9		10		11		12		
5					●								
6	16		17		16		15		14		13		
7													
8	19		20		21		22		23		24		
9													
10	30		29		28		27		26		25		
11													
12	31		32		33		34		35		36		
13													

A. Description of original monument and accessories and/or subsequent restoration:  
E-5  
GLO survey notes - 1832 (Noah Brookfield) set corner  
10" Hemlock - S75° E 22 links  
18" Hemlock - S89° W 24 links  
Kistler notes  
T-iron 2688.80' N of E-6  
LCRC rec. in Liber 6, Page 40 (1981 - Room)  
C.I. mon.  
30" Maple - ESE 6.04'  
46" Cherry - S 11.70'  
20" Cherry - SE 26.02'  
T-iron - S18 E 72.62'


LCRC rec. in Liber 5, Page 89 (1983 - Joiner)  
C.I. mon.  
Maple clump - SE 6.02'  
tw Cherry - S 11.68'  
6" Cherry - NNW 42.78'  
11" Cherry - W 77.02'

B. Description of corner evidence found and/or method applied in restoring or reestablishing corner:  
E-5  
Found C.I. mon. at grade  
Found nail in E side 10" W Cherry - SSE 11.74'  
Found angle iron SSE 74.28'  
Found C.I. mon. in mon. box (E-6) - S 2688.11'

P.A. 345 OTTAWA COUNTY  
PEER APPROVED 6-15-98  
*M.J.R.*

I hereby accept the position of the C.I. mon. as a careful perpetuation of the position of the original corner.

C. Description of monument for corner and accessories established to perpetuate locating the position of the corner:  
E-5  
C.I. mon.  
Set nail and remon. tag in N side 24" stump - S12° E 74.28'  
Set nail and remon. tag in E side tw 20" W Cherry - S0° E 11.74'  
Set nail and remon. tag in N side 18" W Cherry - S72° W 55.76'  
Set nail and remon. tag in S side 12" W Cherry - S80° W 77.19'  
Set nail and remon. tag in E side tw 6" Aspen - N0° E 36.14'  
Set nail and remon. tag in N side 6" Pine - S60° E 25.37'

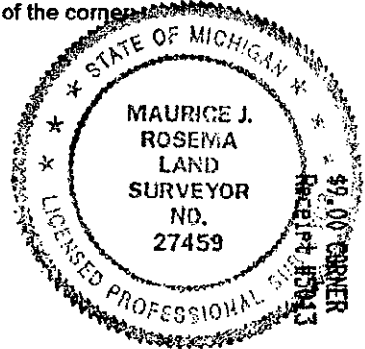

Signed by *Maurice J. Rosema*  
Surveyor's Michigan License No. 27459

Date June 13, 1998