

# SURVEY & REMONUMENTATION

APR 25 1995

COMMISSION

Ottawa County Remonumentation  
**LAND CORNER RECORDATION CERTIFICATE**  
 Filing Requirement of Act 74, Mich. P.A. 1970

RECORDED

94 DEC -8 PM 12: 31

*Robert Williams*  
 REGISTER OF DEEDS  
 OTTAWA COUNTY, MI

For corners in  
Ottawa  
(County)

Located In:

Corner Code #

1. Public Land Survey	T	<u>7N</u>	R	<u>14W</u>	<u>E-6</u>
	T		R		
	T		R		
	T		R		
2. Property Controlling in Section	S		T	R	
	S		T	R	
3. Miscellaneous Property in Sec.	S		T	R	
	S		T	R	

Register of Deeds Stamp & File Number

4. Lot No. \_\_\_\_\_, Recorded Plat \_\_\_\_\_  
 5. Private Claims \_\_\_\_\_

	A	B	C	D	E	F	G	H	I	J	K	L	M
2	6		5		4		3		2				
3													
4	7		8		9		10		11		12		
5													
6	18		17		16		15		14		13		
7													
8	19		20		21		22		23		24		
9													
10	30		29		28		27		26		25		
11													
12	31		32		33		34		35		36		
13													

I, Maurice J. Rosema in a field survey on Oct. 6, 19 94, do hereby certify that under requirements of P.A. 74, Michigan P.A. of 1970, the corner points mentioned in lines 1 and 2 above were in conformance with regulations and rules therefore as required in the current manual of survey instructions of the United States Department of the Interior, Bureau of Land Management or by a decree of a Court of Law and/or that the corner points mentioned in lines 3, 4 and 5 above were in conformance with the rules of the Michigan Board of Land Surveyors or by a Decree of a Court of Law; established, re-established, monumented, re-monumented, recovered, found as expressed below:

**NOTE: Not more than 4 corners, all in the same town and range, may be recorded on this certificate.**

A. Description of original monument and accessories and/or subsequent restoration:

app - 1971 per L.C.R.C.  
 in L. 1, P. 99  
 mon.  
 1 in face of 3" Pine - NE. 60.67'  
 1 in face of 5" Pine - SE. 108.15'  
 1 in face of 5" Pine - SSW. 85.53'

Englert - 1972 per L.C.R.C.  
 rec. in L. 1, P. 611  
 Stake with O.C. Sec. cor. plate  
 5" pine - NNE. 60.77'  
 5" Pine - ESE. 80.13'  
 5" Pine - SW. 91.84'

G.L.O. - 1832 signed by Noah Brookfield for Calvin Britain D.S. Set 1/2 mile post  
 20" Hemlock - S68°E .11 ch.  
 18" Maple - N89°W .27 ch.

B. Description of corner evidence found and/or method applied in restoring or reestablishing corner:


5  
 and C.I. mon. in mon. box in E.-W. bit. conc. road

hereby accept this corner as correct and accurate perpetuation the position of the original corner.

P.A. 345 OTTAWA COUNTY  
 PEER APPROVED 11/21/94  
*Kendrick D. Newell*

C. Description of monument for corner and accessories established to perpetuate locating the position of the corner:

-6  
 -I. mon.  
 at nail and remon. tag in N. side 8" Elm - S3°W 99.44'  
 at nail and remon. tag in W. side P. pole - S71°E 132.56'  
 at nail and remon. tag in E. side wood fence post - N5°E 33.98'  
 at nail and remon. tag in E. side 12" Aspen - N68°W 105.60'  
 at nail and remon. tag in S. side 12" Pine - N31°E 60.72'

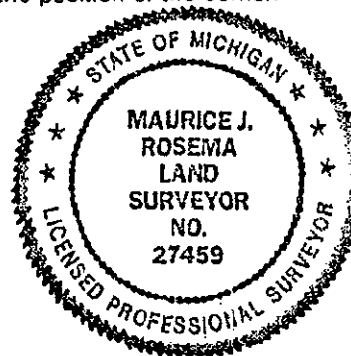

Signed by *Maurice J. Rosema* Date Nov. 19, 1994  
 Surveyor's Michigan License No. 27459