

SURVEY & REMONUMENTATION

APR 24 1995

COMMISSION

Ottawa County Remonumentation

LAND CORNER RECORDATION CERTIFICATE
Filing Requirement of Act 74, Mich. P.A. 1970

RECORDED

94 DEC 15 AM 11:48

Phyllis Holliman
REGISTER OF DEEDS
OTTAWA COUNTY, MI

For corners in

<u>Ottawa</u> (County)	Located In:	Corner Code #
1. Public Land Survey	T <u>7N</u> R <u>14W</u>	<u>E-8</u>
	T _____ R _____	_____
	T _____ R _____	_____
	T _____ R _____	_____
2. Property Controlling in Section	S _____ T _____ R _____	_____
	S _____ T _____ R _____	_____
3. Miscellaneous Property in Sec.	S _____ T _____ R _____	_____
	S _____ T _____ R _____	_____

Register of Deeds Stamp & File Number

4. Lot No. _____, Recorded Plat _____
5. Private Claims _____

Maurice J.
Rosema

Oct. 13 94

I, _____, in a field survey on _____, 19 _____, do hereby certify that under requirements of P.A. 74, Michigan P.A. of 1970, the corner points mentioned in lines 1 and 2 above were in conformance with regulations and rules therefore as required in the current manual of survey instructions of the United States Department of the Interior, Bureau of Land Management or by a decree of a Court of Law and/or that the corner points mentioned in lines 3, 4 and 5 above were in conformance with the rules of the Michigan Board of Land Surveyors or by a Decree of a Court of Law, established, re-established, monumented, re-monumented, recovered, found as expressed below:

A	B	C	D	E	F	G	H	I	J	K	L	M
2	6	5	4	3	2	1						
3												
4	7	8	9	10	11	12						
5												
6	18	17	16	15	14	13						
7												
8	19	20	21	22	23	24						
9												
10	30	29	28	27	26	25						
11												
12	31	32	33	34	35	36						
13												

NOTE: Not more than 4 corners, all in the same town and range, may be recorded on this certificate.

A. Description of original monument and accessories and/or subsequent restoration:

E-8	GLO - 1832 signed by	Greer - 1976 per L.C.R.C. rec. in L. 3, P, 88	Joiner - 1991 per rec. in L. 6, P. 188
	Noah Brookfield for	1" iron pipe	C.I. mon.
	Calvin Britain D.S.	14" Willow - S. 48.59'	10" Willow - NNE. 31.31'
	10" Maple - S47 E .17 ch.	12" tw. Willow - S. 39.95'	8" Cherry - E. 15.13'
	10" Pine - S87 W .23 ch.	4" Cherry - N. 25.71'	6" tw. Willow
		4" Cherry - N. 25.71'	6" tw. Willow - W.

B. Description of corner evidence found and/or method applied in restoring or reestablishing corner: 10.86' fence to E. - 25' 9" Ash - ESE. 17.21'


E-8
Found C.I. mon.
Found nail in N. side 8" Cherry - E. 15.10'
Found nail in N. side 6" tw. Willow - WNW. 10.86'
Found nail in W. side 10" Willow - NNE. 31.33'

P.A. 345 OTTAWA COUNTY
PEER APPROVED 12/12/94
M. Nedewold

I hereby accept this corner as a correct and accurate perpetuation of the position of the original corner.

C. Description of monument for corner and accessories established to perpetuate locating the position of the corner:

E-8
C.I. mon.
Set nail and remon. tag in N. side 8" Cherry - S84°E 15.10'
Set nail and remon. tag in N. side 6" tw. Willow - N72°W 10.86'
Set nail and remon. tag in S. side 12" Ash - S57°E 16.80'
Set nail and remon. tag in W. side 10" Willow - N48°E 31.33'
Set nail and remon. tag in N. side tw. 8" Ash - N70°E 22.06'

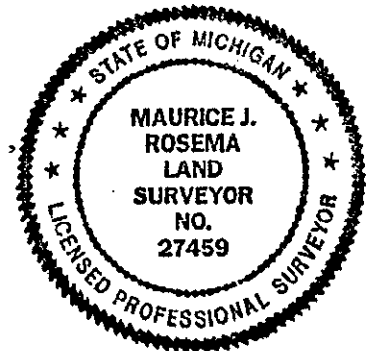

Signed by *Maurice J. Rosema* Date Nov. 19, 1994
Surveyor's Michigan License No. 27459