

**SURVEY &
RE-MONUMENTATION**

Ottawa County Remonumentation

RECORDED

APR 24 1995

LAND CORNER RECORDATION CERTIFICATE

94 DEC 15 AM 11:51

Filing Requirement of Act 74, Mich. P.A. 1970

For corners in **COMMISSION**

Dorothy E. Redburn
REGISTER OF DEEDS
OTTAWA COUNTY, MI

Ottawa (County) Located In: Corner Code #

1. Public Land Survey	T <u>7N</u> R <u>14W</u>	<u>E-13</u>
	T _____ R _____	_____
	T _____ R _____	_____
	T _____ R _____	_____
2. Property Controlling in Section	S _____ T _____ R _____	_____
	S _____ T _____ R _____	_____
3. Miscellaneous Property in Sec.	S _____ T _____ R _____	_____
	S _____ T _____ R _____	_____

Register of Deeds Stamp & File Number

4. Lot No. _____, Recorded Plat _____
5. Private Claims _____

	A	B	C	D	E	F	G	H	I	J	K	L	M
2	6	5	4	3	2	1							
3													
4	7	8	9	10	11	12							
5													
6	18	17	16	15	14	13							
7													
8	19	20	21	22	23	24							
9													
10	30	29	28	27	26	25							
11													
12	31	32	33	34	35	36							
13													

Maurice J. Rosema Jan. 2 94

I, _____, in a field survey on _____, 19 _____, do hereby certify that under requirements of P.A. 74, Michigan P.A. of 1970, the corner points mentioned in lines 1 and 2 above were in conformance with regulations and rules therefore as required in the current manual of survey instructions of the United States Department of the Interior, Bureau of Land Management or by a decree of a Court of Law and/or that the corner points mentioned in lines 3, 4 and 5 above were in conformance with the rules of the Michigan Board of Land Surveyors or by a Decree of a Court of Law; established, re-established, monumented, re-monumented, recovered, found as expressed below:

NOTE: Not more than 4 corners, all in the same town and range, may be recorded on this certificate.

A. Description of original monument and accessories and/or subsequent restoration:

E-13
GLO - (no date) by VanKooten - 1977 per Schiele - 1979 per
Loucius Lyon D.S. L.C.R.C. rec. in L.C.R.C. rec. in
10" B. Ash - N55°W .27 ch. L. 3, P. 243 L. 3, P. 366
7" Walnut - N74°E .35 ch. (over) (over)
Joiner - 1980 per Milliron - 1991 per
L.C.R.C. rec. in L.C.R.C. rec. in
L. 4, P. 136 L. 6, P. 150

B. Description of corner evidence found and/or method applied in restoring or reestablishing corner:


E-13
Found C.I. mon.
C.I. mon. - W. 6.96'
Spike in NE. side P. pole - N45 W 36.32'

P.A. 345 OTTAWA COUNTY
PEER APPROVED 4/18/94
Kendall E. Rosema

I hereby accept this corner as a correct and accurate perpetuation of the position of the original corner.

C. Description of monument for corner and accessories established to perpetuate locating the position of the corner:

E-13
C.I. mon.
Set nail and remon. tag in NE. side P. pole - N45°W 36.32'
Set nail and remon. tag in SE. side wood post - S67°W 48.15'
C.I. mon. - W. 6.96'
Centerline of top hydrant - N30°E 31.34'
Centerline of street sign post - N49°W 43.28'
On centerline of E.-W. bit. conc. road
Centerline of gravel road to S - W. 2'

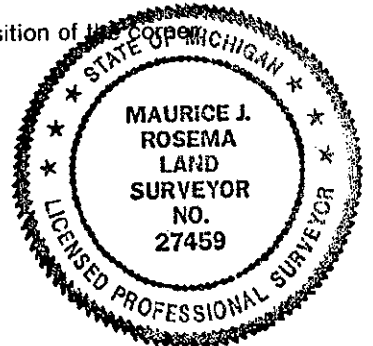

Signed by *Maurice J. Rosema* Date April 18, 1994
Surveyor's Michigan License No. 27459

Part A - continued

VanKooten - 1977 per L.C.R.C. rec. in L. 3, P. 243

T-iron

Nail in SE. side P. pole - NE. 68.47'

Nail in NE. side P. pole - NW. 37.51'

Sq. spike in W. side 20" Ash - SSE. 198.08'

Schiele - 1979 per L.C.R.C. rec. in L. 3, P. 366

T-iron

P. pole - NW. 42.80'

P. pole - NW. 37.52'

P. pole (side) - NE. 68.47'

Blendon cor. - W. 6.96'

Joiner - 1980 per L.C.R.C. rec. in L. 4, P. 136

C.I. mon.

P. pole - NW. 37.57'

Street sign - N. 18.96'

Power pole - NE. 74.57'

Blendon cor. - W. 6.97'

Milliron - 1991 per L.C.R.C. rec. in L. 6, P. 150

C.I. mon.

16-d nail in NE. side Power pole - N45°W 36.33'

16-d nail in S. side P. pole - N60°E 64.22'

1/2" rebar at SE. cor. intersection - S15°E 63.31'

P.K. in E. side 6" post - S20°W 79.29'

16-d nail in N. side 4" post - N50°W 52.67'

Blendon cor. - W. 6.98'