

SURVEY & REMONUMENTATION

APR 24 1995

Ottawa County Remonumentation
LAND CORNER RECORDATION CERTIFICATE
Filing Requirement of Act 74, Mich. P.A. 1970

RECORDED

94 DEC 15 AM 11:48

For corners in **COMMISSION**
Ottawa

(County)	Located In:	Corner Code #
1. Public Land Survey	T <u>7N</u> R <u>14W</u>	<u>F-7</u>
	T _____ R _____	_____
	T _____ R _____	_____
	T _____ R _____	_____
2. Property Controlling in Section	S _____ T _____ R _____	_____
	S _____ T _____ R _____	_____
3. Miscellaneous Property in Sec.	S _____ T _____ R _____	_____
	S _____ T _____ R _____	_____

Richard S. Chalmers
REGISTER OF DEEDS
OTTAWA COUNTY, MI

Register of Deeds Stamp & File Number

4. Lot No. _____, Recorded Plat _____
5. Private Claims _____

	A	B	C	D	E	F	G	H	I	J	K	L	M
2	6	5	4	3	2	1							
3													
4	7	8	9	10	11	12							
5													
6	18	17	16	15	14	13							
7													
8	19	20	21	22	23	24							
9													
10	30	29	28	27	26	25							
11													
12	31	32	33	34	35	36							
13													

I, Maurice J. Rosema, in a field survey on Oct. 6, 19 94, do hereby certify that under requirements of P.A. 74, Michigan P.A. of 1970, the corner points mentioned in lines 1 and 2 above were in conformance with regulations and rules therefore as required in the current manual of survey instructions of the United States Department of the Interior, Bureau of Land Management or by a decree of a Court of Law and/or that the corner points mentioned in lines 3, 4 and 5 above were in conformance with the rules of the Michigan Board of Land Surveyors or by a Decree of a Court of Law; established, re-established, monumented, re-monumented, recovered, found as expressed below:

NOTE: Not more than 4 corners, all in the same town and range, may be recorded on this certificate.

A. Description of original monument and accessories and/or subsequent restoration:

- | |
|--|
| F-7
Englert - 1972 per L.C.R.C. Greer - 1976 per L.C.R.C. Joiner - 1980 per L.C.R.C.
rec. in L. 1, P. 489 rec. in L. 3, P. 89 rec. in L. 4, P. 125 |
| 1" Pipe 3/4" iron pipe C.I. mon. |
| 16" Maple - NW. 44.23' 40" Oak - ESE 85.93' 12" Pine - S. 24.65' |
| 26" Maple - NNW. 23.75' 26" Maple - NNW. 23.78' 42" Oak - SE. 86.25' |
| 40" Oak - ESE. 85.93' 16" Maple - NW. 44.33' 24" Maple - N. 23.87' |
| Steel rod - S. 33.00' 17" Maple - NW. 43.84' |

B. Description of corner evidence found and/or method applied in restoring or reestablishing corner:

- | | |
|---|---|
| F-7
C.I. mon.
Found nail in SW. side 15" stump - NW. 43.85'
Found P.K. nail in SE. side P. pole - SW. 40.60'
Found nail in NE. side 40" Maple N. 23.82' | Rosema - 1985 per L.C.R.C. rec. in L. 5, P. 200
C.I. mon.
Nail and b.c. in SW. side 15" Stump - NW. 43.83'
Nail and b.c. in E. side 26" Maple - NNW. 23.82'
Nail and b.c. in SW. side 48" Oak - SSE. 86.20'
P.K. nail in SE. side P. pole - SW. 40.50' |
|---|---|

I hereby accept this corner as a correct and accurate perpetuation on the position of the original corner.


G.L.O. - 1832 signed by Noah Brookfield for Calvin Britain D.S.
10" Maple - S35°E .20 ch.
10" Maple - N79°W .21 ch.

P.A. 345 OTTAWA COUNTY

PEER APPROVED 12/12/94

C. Description of monument for corner and accessories established to perpetuate locating the position of the corner:

- F-7
C.I. mon.
Set nail and remon. tag in SW. side 15" stump - N54°W 43.85'
Set nail and remon. tag in SE. side P. pole - S59°W 40.60'
Set nail and remon. tag in NE. side 24" Maple - N5°W 23.82'
Set nail and remon. tag in NW. side 43" Maple - S69°E 84.28'
Set nail and remon. tag in W. side 13" Pine - S0°E 50.35'

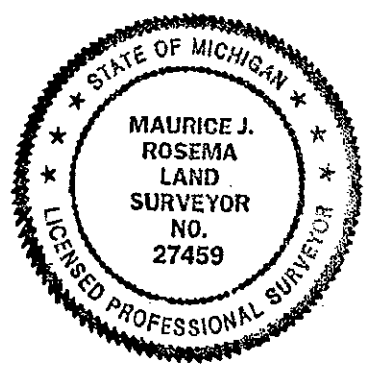

Signed by Maurice J. Rosema Date Nov. 19, 1994
Surveyor's Michigan License No. 27459