

SURVEY & REMONUMENTATION

Ottawa County Remonumentation

RECORDED

APR 24 1995

LAND CORNER RECORDATION CERTIFICATE

94 DEC 15 AM 11:53

Filing Requirement of Act 74, Mich. P.A. 1970

For corners in **COMMISSION**

Phyllis Robinson
REGISTER OF DEEDS
OTTAWA COUNTY, MI

Ottawa (County)	Located In:	Corner Code #
1. Public Land Survey	T <u>7N</u> R <u>14W</u>	<u>F-13</u>
	T _____ R _____	_____
	T _____ R _____	_____
	T _____ R _____	_____
2. Property Controlling in Section	S _____ T _____ R _____	_____
	S _____ T _____ R _____	_____
3. Miscellaneous Property in Sec.	S _____ T _____ R _____	_____
	S _____ T _____ R _____	_____
4. Lot No. _____, Recorded Plat _____		
5. Private Claims _____		

Register of Deeds Stamp & File Number

	A	B	C	D	E	F	G	H	I	J	K	L	M
2	6	5	4	3	2	1							
3													
4	7	8	9	10	11	12							
5													
6	18	17	16	15	14	13							
7													
8	19	20	21	22	23	24							
9													
10	30	29	28	27	26	25							
11													
12	31	32	33	34	35	36							
13													

Maurice J. Rosema Dec. 8 94
I, _____, in a field survey on _____, 19 _____, do hereby certify that under requirements of P.A. 74, Michigan P.A. of 1970, the corner points mentioned in lines 1 and 2 above were in conformance with regulations and rules therefore as required in the current manual of survey instructions of the United States Department of the Interior, Bureau of Land Management or by a decree of a Court of Law and/or that the corner points mentioned in lines 3, 4 and 5 above were in conformance with the rules of the Michigan Board of Land Surveyors or by a Decree of a Court of Law; established, re-established, monumented, re-monumented, recovered, found as expressed below:

NOTE: Not more than 4 corners, all in the same town and range, may be recorded on this certificate.

A. Description of original monument and accessories and/or subsequent restoration:
F-13

GLO - no date by VanKooten - 1977 per L.C.R.C. Joiner - 1980 per L.C.R.C.
Loucius Lyon D.S. rec. in L. 3, P. 243 (over) rec. in L. 4, P. 138 (over)
Set H.M.P.
9" B. Ash - N73 E .33 ch. Clapp - 1978 per L.C.R.C. Rosema - 1986 per L.C.R.C. (over)
9" Pine - N76 W .31 ch. rec. in L. 3, P. 309 (over) Brintnall - 1991 per L.C.R.C. (over)


B. Description of corner evidence found and/or method applied in restoring or reestablishing corner:
F-13

Found C.I. mon. in mon. box
Found nail in E. side Power pole - N40° W 84.43'
Found C.I. mon. in mon. box - W. 21.15'
Found P.K. nail in top of 4" wood post - S50° E 50.18'
Found x cut in S. end conc. culvert - S45° W 41.90'
Found P.K. nail in top of 9" post - S55° W 61.12'
Center of top of hydrant - N65° E 47.48'
I hereby accept this corner as a correct and accurate perpetuation of the position of the original corner.

P.A. 345 OTTAWA COUNTY
PEER APPROVED 12/12/94
Victor P. Nedeweld

C. Description of monument for corner and accessories established to perpetuate locating the position of the corner:
F-13

C.I. mon. in mon. box
Set nail and remon. tag in E. side Power pole - N40° W 84.43'
Set nail and remon. tag in top of 4" wood post - S50° E 50.18'
Set nail and remon. tag in top of 9" wood post - S55° W 61.12'
Set nail and remon. tag in E. side Power pole - N32° E 66.31'
C.I. mon. in mon. box - N90 W 21.15'

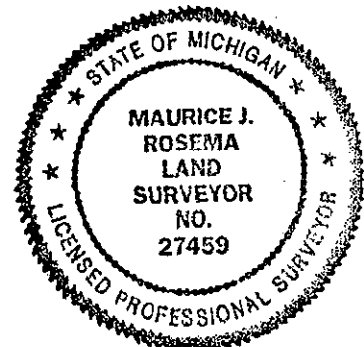

Dec. 10, 1994

Signed by *Maurice J. Rosema* Date _____
Surveyor's Michigan License No. 27459

Part A - continued

VanKooten - 1977 per L.C.R.C. rec. in L. 3, P. 243

T-iron

P.K. nail in NW. side Power pole - SW. 56.60'

P.K. nail in SW. side Power pole - SE. 49.74'

P.K. nail in SE. side Power pole - NW. 71.52'

Clapp - 1978 per L.C.R.C. rec. in L. 3, P. 309

Chisel

Blendon corner - W. 21.29'

Centerline street sign - SE. 47.75'

Power pole - NW. 84.10'

Phone post - SE. 49.80'

Joiner - 1980 per L.C.R.C. rec. in L. 4, P. 138

C.I. mon.

Tele. ped. - SW. 52.90'

Power pole - NW. 83.65'

Street sign - SE. 47.97'

Tele. ped. - SE. 49.65'

Blendon cor. - W. 21.20'

Rosema - 1986 per L.C.R.C.

C.I. mon.

Center of Tele. ped. - SE. 52.90'

Nail and B.C. in E. side Power pole - NW. 83.80'

Centerline of street sign - SE. 47.80'

C.I. mon. (Blendon cor.) - W. 21.22'

P.K. nail in top of wood post at tele. post - SW. 53.10'

Nail and tag in SW. side wood post at tele. box - SE. 49.85'

Brintnall- 1991 per L.C.R.C.

C.I. mon.

P.K. nail in tip of 4" post - S60°E 49.72'

Centerline of top of hyd. - N65°E 47.42'

P.K. nail in E. side Power pole - N50°W 84.20'

x cut in s. end of conc. culv. - S45°W 41.81'

P.K. nail in centerline of bit. - S0°E 99.95'

Sec. cor. - W. 21.16'

1991
3005
1991
3005
10
01