

**SURVEY &
REMONUMENTATION**

DEC 01 1998

SECTION

**Ottawa County Remonumentation
LAND CORNER RECORDATION CERTIFICATE
Filing Requirement of Act 74, Mich. P.A. 1970**

For corners in

| | | |
|------------------------------------|---|-----------------------|
| <u>Ottawa</u> (County) | Located In: | Corner Code # |
| 1. Public Land Survey | T <u>7N</u> R <u>14W</u> | <u>G-1</u> |
| | T <u> </u> R <u> </u> | <u>NW cor. Sec. 3</u> |
| | T <u> </u> R <u> </u> | <u>Polkton Twp</u> |
| | T <u>8N</u> R <u>14W</u> | <u>G-13</u> |
| 2. Property Controlling in Section | S <u> </u> T <u> </u> R <u> </u> | _____ |
| | S <u> </u> T <u> </u> R <u> </u> | _____ |
| 3. Miscellaneous Property in Sec. | S <u> </u> T <u> </u> R <u> </u> | _____ |
| | S <u> </u> T <u> </u> R <u> </u> | _____ |

RECORDED

98 JUL 24 PM 1:47

Dan Schiller
REGISTER OF DEEDS
OTTAWA COUNTY, MI

Register of Deeds Stamp & File Number

4. Lot No. _____, Recorded Plat _____
5. Private Claims _____

| | | | | | | | | | | | | | |
|----|----|---|----|---|----|---|----|---|----|---|----|---|---|
| | A | B | C | D | E | F | G | H | I | J | K | L | M |
| 1 | | | | | | | | | | | | | |
| 2 | 6 | | 5 | | 4 | | 3 | | 2 | | 1 | | |
| 3 | | | | | | | | | | | | | |
| 4 | 7 | | 8 | | 9 | | 10 | | 11 | | 12 | | |
| 5 | | | | | | | | | | | | | |
| 6 | 18 | | 17 | | 16 | | 15 | | 14 | | 13 | | |
| 7 | | | | | | | | | | | | | |
| 8 | 19 | | 20 | | 21 | | 22 | | 23 | | 24 | | |
| 9 | | | | | | | | | | | | | |
| 10 | 30 | | 29 | | 28 | | 27 | | 26 | | 25 | | |
| 11 | | | | | | | | | | | | | |
| 12 | 31 | | 32 | | 33 | | 34 | | 35 | | 36 | | |
| 13 | | | | | | | | | | | | | |

I, Maurice J. Rosema, in a field survey on Jan. 28, 1998 do hereby state that under requirements of P.A. 74, Michigan P.A. of 1970, the corner points mentioned in lines 1 and 2 above were in conformance with regulations and rules therefore as required in the current manual of survey instructions of the United States Department of the Interior, Bureau of Land Management or by a decree of a Court of Law and /or that the corner points mentioned in lines 3, 4 and 5 above were in conformance with the rules of the Michigan Board of Land Surveyors or by a Decree of a Court of Law; established, re-established, monumented, recovered, found as expressed below:

NOTE: Not more than 2 corners, all in the same town and range, may be recorded on this certificate.

A. Description of original monument and accessories and/or subsequent restoration:

G-1
GLO survey notes - 1837
6" Leym - S29°W 22 links
13" Hemlock - S73°E 31 links
LCRC rec. in Liber 1, Page 727 (1972 - Spicer)
nail and tag in c/l 8" Oak - S50°E 35.70'
nail and tag in c/l 8" Oak - N0°W 29.15'
nail and tag in c/l 28" Hackberry - N50 E 51.30'

LCRC rec. in Liber 3, Page 574 (1997 by Vugteveen)
(rec. as F-13, T8N, R14W) C.I. mon.
nail and OC remon. tag in SE side 21" tw Oak - AZ 193° 31.07'
nail and OC remon. tag in NW side 10" Oak - AZ 230° 43.57'
nail and OC remon. tag in E side 24" Oak - N 29.58'
nail and OC remon. tag in SE side 36" Oak - AZ 51° 50.96'
Centerline of E-W road N 0'
On centerline of tree row to N


B. Description of corner evidence found and/or method applied in restoring or reestablishing corner:

G-1
Found C.I. mon. 0.3' below grade
Found nail and remon. tag in E side tw 10" Oak - SSW 31.11'
Found nail and remon. tag in NW side tri 8" Oak - WSW 43.61'
Found nail and remon. tag in E side 20" Oak - N 29.61'
Found nail and remon. tag in SE side 36" Hackberry - NE 51.00'
Center of 20" Oak - N 29.15'
Center of 36" Hackberry - NE 51.3'
On centerline of E-W gravel road, on brush/tree row to N
I hereby accept the position of the C.I. mon. as a careful perpetuation of the position off the original corner.

C. Description of monument for corner and accessories established to perpetuate locating the position of the corner:

G-1
C.I. mon.
Found nail and remon. tag in E side tw 10" Oak - S17°W 31.11'
Found nail and remon. tag in NW side tri 8" Oak - S55°W 41.61'
Found nail and remon. tag in E side 20" Oak - N5°E 29.61'
Found nail and remon. tag in SE side 36" Hackberry - N55°E 51.00'
On centerline of E-W gravel road, on brush/tree row to N
This corner is common with G-13, T8N, R14W

PREP APPROVED 6-15-98
S.D.T.

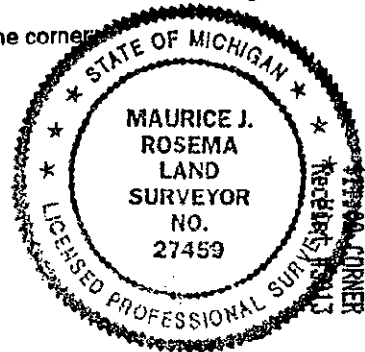

Signed by Maurice J. Rosema
Surveyor's Michigan License No. 27459

Date June 13, 1998

SURVEY &
REMONUMENTATION

DEC 01 1998

SECTION

