

# SURVEY & REMONUMENTATION

APR 25 1995

COMMISSION

Ottawa County Remonumentation  
LAND CORNER RECORDATION CERTIFICATE  
Filing Requirement of Act 74, Mich. P.A. 1970

RECORDED

94 DEC -8 PM 12:30

*D. J. ...*  
REGISTER OF DEEDS  
OTTAWA COUNTY, MI

For corners in

Ottawa <small>(County)</small>	Located In:	Corner Code #/
1. Public Land Survey	T <u>7N</u> R <u>14W</u>	<u>G-6</u>
	T _____ R _____	_____
	T _____ R _____	_____
	T _____ R _____	_____
2. Property Controlling in Section	S _____ T _____ R _____	_____
	S _____ T _____ R _____	_____
3. Miscellaneous Property in Sec.	S _____ T _____ R _____	_____
	S _____ T _____ R _____	_____

Register of Deeds Stamp & File Number

4. Lot No. \_\_\_\_\_, Recorded Plat \_\_\_\_\_  
5. Private Claims \_\_\_\_\_

	A	B	C	D	E	F	G	H	I	J	K	L	M
2	6	5	4	3	2	1							
3													
4	7	8	9	10	11	12							
5													
6	18	17	16	15	14	13							
7													
8	19	20	21	22	23	24							
9													
10	30	29	28	27	26	25							
11													
12	31	32	33	34	35	36							
13													

I, Maurice J. Rosema, in a field survey on Oct. 6, 19 94, do hereby certify that under requirements of P.A. 74, Michigan P.A. of 1970, the corner points mentioned in lines 1 and 2 above were in conformance with regulations and rules therefore as required in the current manual of survey instructions of the United States Department of the Interior, Bureau of Land Management or by a decree of a Court of Law and/or that the corner points mentioned in lines 3, 4 and 5 above were in conformance with the rules of the Michigan Board of Land Surveyors or by a Decree of a Court of Law; established, re-established, monumented, re-monumented, recovered, found as expressed below:

**NOTE: Not more than 4 corners, all in the same town and range, may be recorded on this certificate.**

A. Description of original monument and accessories and/or subsequent restoration:

<p>1. <u>maker</u> - 1978 per L.C.R.C. rec. in L. 3, P. 333 1/2" in mon. box 1/2" in SW. side T. pole - SE. 33.22' 1/2" in NW. side fence post - NE. 45.38' centerline of street sign - S. 31.67'</p>	<p>2. <u>Rosema</u> - 1985 per L.C.R.C. rec. in L. 5, P. 200 1/2" rod in mon. box P.K. nail in SW. side T. pole - SE. 33.29' P.K. nail in NW. side fence post - NE. 45.41' Centerline of street sign - S. 31.59'</p>	<p>3. <u>Joiner</u> - 1991 per L.C.R.C. rec. in L. 6, P. 189 C.I. mon. T. pole - NW. 49.45' Fence post - NE. 45.42' T. post - SSW. 32.26' T. post - SE. 33.14'</p>
---	--	--

B. Description of corner evidence found and/or method applied in restoring or reestablishing corner:

<p>1. <u>centerline of street sign</u> - S. 32.80' <u>post</u> - NNW. 49.50'</p>	<p>1. <u>Britnall</u> - 1993 per L.C.R.C. rec. in L. 6, P. 254 C.I. mon. P.K. in SW. side T. post - NW. 49.42' P.K. in NW. side fence post - NE. 45.42' P.K. in E. side T. post - SSW. 32.26' P.K. in W. side T. post - SE. 33.09' P.K. in P. pole - ESE. 104.60'</p>
--	---

I hereby accept this corner as a correct and accurate perpetuation of the position of the original corner


G.L.O. - 1832 signed by Noah Brookfield for Calvin Britain D.S.S. Set 1/2 mile post  
30" Pine - N22°W .11 ch.  
16" Maple - S66°E .11 ch.

C. Description of monument for corner and accessories established to perpetuate locating the position of the corner:

1. 1/2" nail and remon. tag in NW. side 26" stump - S55°E 59.35'  
2. 1/2" nail and remon. tag in NW. side 25" Elm - S33°E 86.05'  
3. 1/2" nail and remon. tag in S. side T. post - N32°W 49.50'  
4. 1/2" nail and remon. tag in SE. side 24" Elm - N70°W 105.12'

PA. 345 OTTAWA COUNTY

PEER APPROVED 11/21/94  
*Richard P. Medwede*

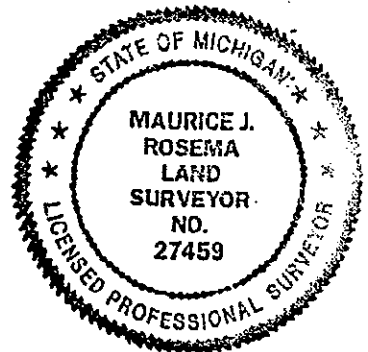

Signed by Maurice J. Rosema Date Nov. 19, 1994  
Surveyor's Michigan License No. 27459