

**SURVEY &
REMONUMENTATION**

APR 25 1995

COMMISSION

Ottawa County Remonumentation
LAND CORNER RECORDATION CERTIFICATE
Filing Requirement of Act 74, Mich. P.A. 1970

RECORDED

94 DEC -8 PM 12:31

Edythe Robinson
REGISTER OF DEEDS
OTTAWA COUNTY, MI

For corners in


Ottawa (County)	Located In:	Corner Code #
1. Public Land Survey	T <u>7N</u> R <u>14W</u>	<u>G-7</u>
	T _____ R _____	_____
	T _____ R _____	_____
	T _____ R _____	_____
2. Property Controlling in Section	S _____ T _____ R _____	_____
	S _____ T _____ R _____	_____
3. Miscellaneous Property in Sec.	S _____ T _____ R _____	_____
	S _____ T _____ R _____	_____

Register of Deeds Stamp & File Number

4. Lot No. _____, Recorded Plat _____
5. Private Claims _____

Maurice J. Rosema in a field survey on Oct. 10, 19 94, do hereby certify that under requirements of P.A. 74, Michigan P.A. of 1970, the corner points mentioned in lines 1 and 2 above were in conformance with regulations and rules therefore as required in the current manual of survey instructions of the United States Department of the Interior, Bureau of Land Management or by a decree of a Court of Law and/or that the corner points mentioned in lines 3, 4 and 5 above were in conformance with the rules of the Michigan Board of Land Surveyors or by a Decree of a Court of Law; established, re-established, monumented, re-monumented, recovered, found as expressed below:

NOTE: Not more than 4 corners, all in the same town and range, may be recorded on this certificate.

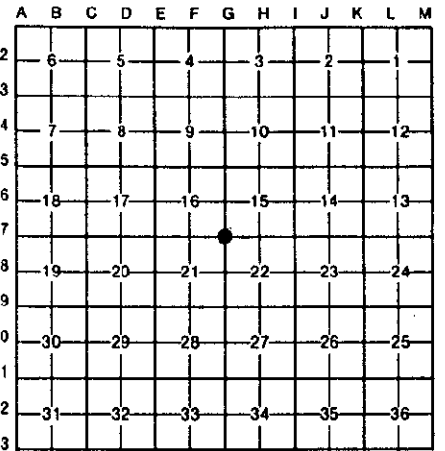

A. Description of original monument and accessories and/or subsequent restoration:

- | | | |
|--|---|--|
| 7
on - 1979 per L.C.R.C.
in L. 3, P. 389
pipe and stone
N. edge of drain
ans. pole - SSW. 33.70'
up cont. pole - ENE. 19.09'
end culvert - ESE. 19.2' | Bonnema - 1981 per L.C.R.C.
rec. in L. 4, P. 155
Iron
P.K. in S. side P. pole - NE. 19.29'
P.K. in W. side P. pole - SSW. 33.69'
Capped iron - NNE. 16.37'
Top W. end culvert - ESE. 22.77'
On N. edge of drainage ditch | Rosema - 1985 per L.C.R.C.
rec. in L. 5, P. 200
1/2" iron
P.K. nail in W. side P.
pole - SSW. 33.70'
P.K. nail in N. side P.
pole - NE. 19.69'
Top W. end conc. culvert
ESE. 22.67'
On N. edge drainage ditch |
|--|---|--|

3. Description of corner evidence found and/or method applied in restoring or reestablishing corner:

- | | |
|---|---|
| 7
C. mon.
and P.K. nail in W. side P. pole -
SSW. 33.72'
and P.K. nail in N. side P. pole -
N. side P. pole - NE. 19.69' | Britnall - 1993 per L.C.R.C.
rec. in L. 6, P. 251
1/2" Pipe
P.K. in W. side P. pole - SSW. 33.70'
P.K. in N. side P. pole - ENE. 19.09'
Top W. end culvert - ESE. 22.67'
W. 1/4 cor., Sec. 15 - N. 2666.11'
S. 1/4 cor., Sec. 15 - E. 2644.94' |
|---|---|

hereby accept this corner as a correct
and accurate perpetuation of the position
of the original corner.

C. Description of monument for corner and accessories established to perpetuate locating the position of the corner:

- 7
I. mon.
t nail and remon. tag in W. side P. pole - S25°W 33.72'
t nail and remon. tag in N. side P. pole - N67°E 19.68'
end conc. culvert - S65°E 22.81'
t nail and remon. tag in W. side wood post - N79°E 14.50'
t nail and remon. tag in W. side Willow - S70°E 56.33'

G.L.O. - 1832 signed by Noah Brookfield for
Calvin Britain D.S. Set corner
18" Beech - N28°E 20" Hemlock - S28°W .18 ch.



PA. 345 OTTAWA COUNTY

PEER APPROVED 11/21/94

Signed by Maurice J. Rosema Date Nov. 19, 1994

Surveyor's Michigan License No. 27459

FORM APPROVED BY MICHIGAN STATE BOARD OF LAND SURVEYORS, JAN. 28, 1971
REVISED MAY 14, 1975
REVISED JAN., 1983