

SURVEY & REMONUMENTATION

APR 24 1995

COMMISSION

For corners in

Ottawa County Remonumentation

RECORDED

LAND CORNER RECORDATION CERTIFICATE
Filing Requirement of Act 74, Mich. P.A. 1970

94 DEC 15 AM 11:51

Richard R. Rosema
REGISTER OF DEEDS
OTTAWA COUNTY, MI

<u>Ottawa</u> (County)	Located In:	Corner Code #
1. Public Land Survey	T <u>7N</u> R <u>14W</u>	<u>G-11</u>
	T _____ R _____	_____
	T _____ R _____	_____
	T _____ R _____	_____
2. Property Controlling in Section	S _____ T _____ R _____	_____
	S _____ T _____ R _____	_____
3. Miscellaneous Property in Sec.	S _____ T _____ R _____	_____
	S _____ T _____ R _____	_____

Register of Deeds Stamp & File Number

4. Lot No. _____, Recorded Plat _____
5. Private Claims _____

	A	B	C	D	E	F	G	H	I	J	K	L	M
2	6	5	4	3	2	1							
3													
4	7	8	9	10	11	12							
5													
6	18	17	16	15	14	13							
7													
8	19	20	21	22	23	24							
9													
10	30	29	28	27	26	25							
11													
12	31	32	33	34	35	36							
13													

Maurice J. Rosema

April 12 94

I, _____, in a field survey on _____, 19 _____, do hereby certify that under requirements of P.A. 74, Michigan P.A. of 1970, the corner points mentioned in lines 1 and 2 above were in conformance with regulations and rules therefore as required in the current manual of survey instructions of the United States Department of the Interior, Bureau of Land Management or by a decree of a Court of Law and/or that the corner points mentioned in lines 3, 4 and 5 above were in conformance with the rules of the Michigan Board of Land Surveyors or by a Decree of a Court of Law; established, re-established, monumented, re-monumented, recovered, found as expressed below:

NOTE: Not more than 4 corners, all in the same town and range, may be recorded on this certificate.

A. Description of original monument and accessories and/or subsequent restoration:

G-11	GLO - 1832 signed by Noah Brookfield for Calvin Britain D.S.	Clapp - 1971 per L.C.R.C. rec. in L. 1, P. 153 (over)	Rosema - 1986 per L.C.R.C. rec. in L. 5, P. 240 (over)
	9" Beech - S28°W .14 ch.	Joiner - 1981 per L.C.R.C. rec. in L. 4, P. 195	
	9" Sugar - N41°E .11 ch.	(over)	


B. Description of corner evidence found and/or method applied in restoring or reestablishing corner:

G-11
Found C.I. mon. in mon. box
Found nail in W. side p. pole - N1°E 44.45'
Centerline St. sign - N11°W 29.55'

P.A. 345 OTTAWA COUNTY
PEER APPROVED 4/18/94

Maurice J. Rosema

I hereby accept this corner as a correct and accurate perpetuation of the position of the original corner.

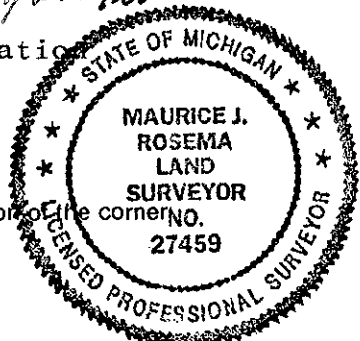

C. Description of monument for corner and accessories established to perpetuate locating the position of the corner:

G-11
C.I. mon. in mon. box
Set nail and remon. tag in W. side P. pole - N1°E 44.45'
Set nail and remon. tag in W. side wood fence post - S26°E 43.52'
Set nail and remon. tag in W. side wood fence post - S41°E 40.06'
Set nail and remon. tag in N. side wood fence post - S50°E 49.84'
Centerline St. sign - N11°W 29.55'

Signed by *Maurice J. Rosema* Date April 18, 1994
Surveyor's Michigan License No. 27459

Part A - continued

Clapp - 1971 per L.C.R.C. rec. in L. 1, P. 153

Iron pipe

Nail in face of T. pole - ESE. 131.65°

Nail in face of T. pole - SW. 58.00°

Centerline of Street sign - N. 20.56°

Joiner - 1981 per L.C.R.C. rec. in L. 4, P. 195

C.I. mon.

P. pole - N. 44.38°

Street sign - NNW. 29.70°

Corner fence post - SE. 39.68°

Wood post - SW. 58.51°

Rosema - 1986 per L.C.R.C. rec. in L. 5, P. 240

C.I. mon. in mon. box

Nail in W. side P. pole - N. 44.36°

Centerline Street sign - NW. 29.82°

Nail in N. side leaning wood post - WSW. 57.64°

P.K. nail and tag in SW. side wood fence post - SE. 41.79

0012
H 2000
CORNER
DOWEL
H 2000

0012
H 2000
CORNER
DOWEL
H 2000