

SURVEY & REMONUMENTATION

DEC 01 1998

Ottawa County Remonumentation

SECTION

LAND CORNER RECORDATION CERTIFICATE
Filing Requirement of Act 74, Mich. P.A. 1970

For corners in

<u>Ottawa</u> (County)	Located In:	Corner Code #	
1. Public Land Survey	T <u>7N</u> R <u>14W</u>	<u>H-1</u>	
	T ___ R ___	<u>N 1/4 cor. Sec. 3</u>	
	T ___ R ___	<u>Polkton Twp</u>	
	T <u>8N</u> R <u>14W</u>	<u>H-13</u>	
2. Property Controlling in Section	S ___ T ___ R ___	___	
	S ___ T ___ R ___	___	
3. Miscellaneous Property in Sec.	S ___ T ___ R ___	___	
	S ___ T ___ R ___	___	

RECORDED

98 JUL 24 PM 1:45

Gary Schmitt
REGISTER OF DEEDS
OTTAWA COUNTY, MI

Register of Deeds Stamp & File Number

4. Lot No. _____, Recorded Plat _____
5. Private Claims _____

I, Maurice J. Rosema, in a field survey on Jan. 28, 1998 do hereby state that under requirements of P.A. 74, Michigan P.A. of 1970, the corner points mentioned in lines 1 and 2 above were in conformance with regulations and rules therefore as required in the current manual of survey instructions of the United States Department of the Interior, Bureau of Land Management or by a decree of a Court of Law and/or that the corner points mentioned in lines 3, 4 and 5 above were in conformance with the rules of the Michigan Board of Land Surveyors or by a Decree of a Court of Law; established, re-established, monumented, recovered, found as expressed below:

NOTE: Not more than 2 corners, all in the same town and range, may be recorded on this certificate.

A	B	C	D	E	F	G	H	I	J	K	L	M
1												
2	6	5	4	3	2	1						
3												
4	7	8	9	10	11	12						
5												
6	18	17	16	15	14	13						
7												
8	19	20	21	22	23	24						
9												
10	30	29	28	27	26	25						
11												
12	31	32	33	34	35	36						
13												

A. Description of original monument and accessories and/or subsequent restoration:

<p>H-1 This corner was not set by GLO</p>	<p>LCRC rec. in Liber 1, Page 727 RR spike nail and tag in c/l CP pole - N65°E 44.50' nail and tag in c/l guy pole - N70°W 44.80' c/l stop sign - S70 W 39.90'</p>	<p>LCRC rec. in Liber 6, Page 181 C.I. mon. PK nail in power pole - NE 55.90' St sign - SW 41.63' x on N end 15" conc. culv. - NW 41.77' x on E end 24" conc. culv. - SE 106.88'</p>
<p>LCRC rec. in Liber 3, Page 575 (rec. as H-13, T8N, R14W) - over</p>	<p>LCRC rec. in Liber 5, Page 25 (rec. as H-13, T8N, R14W) - over</p>	

B. Description of corner evidence found and/or method applied in restoring or reestablishing corner:


H-1
Found C.I. mon. in mon. box
Found nail and remon. tag in SE side power pole - NE 55.90'
Found x cut in N end 12" conc. culvert - NW 41.90'
Found PK nail in SE side power pole - NE 55.90'
Center of street sign (at base) - SW 41.63'

OTAWA COUNTY
PEER APPROVED 6-15-98
M.J.R.

I hereby accept the C.I. mon. as the position of the corner.

C. Description of monument for corner and accessories established to perpetuate locating the position of the corner:

H-1
C.I. mon. in mon. box
Found nail and remon. tag in SE side power pole - N62°E 55.90'
Found x cut in N end conc. culvert - N45°W 41.90'
Set brass rivet in E end of 24" conc. culvert - S15°E 106.76'
Set brass rivet in S end of 12" conc. culvert - S55°W 40.50'
Centerline of N-S bit. conc. road - E 3', on centerline of E-W gravel road
This corner is common with H-13, T8N, R14W

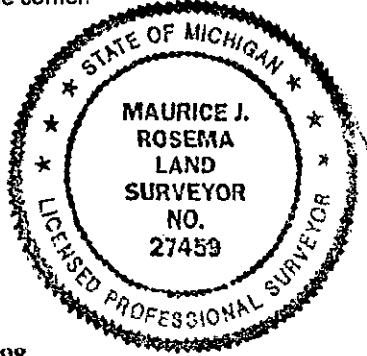

Signed by *M. J. Rosema*
Surveyor's Michigan License No. 27459

Date June 13, 1998

SURVEY &
REMONUMENTATION

DEC 01 1998

SECTION

LCRC per Liber 5, Page 25 (recorded as H-13, T8N, R14W)
(1983 - Brintnall)

1" iron in mon. box

PK nail in power pole (above old PK) - NE 55.88'

c/l street sign - SE 45.24'

PK in fence corner - SW 56.71'

c/l crack - E 2.6'

LCRC per Liber 3, Page 575 (recorded as H-13, T8N, R14W)
(1997 - Vugtevent)

C.I. mon. in mon. box

nail and OC remon. tag in SE side power pole - AZ 58° 55.86'

nail and OC remon. tag in NE side power pole - AZ 162° 162.47'

N.A. capped rebar - AZ 299° 56.96'

N.A. capped rebar - AZ 241° 56.59'

Centerline of N-S road - E 3'

Centerline of E-W road - S 1.5'

