

1988

COMMISSION

Ottawa County remonumentation

LAND CORNER RECORDATION CERTIFICATE  
Filing Requirement of Act 74, Mich. P.A. 1970

RECORDED

93 DEC 15 AM 9:28

*Register of Deeds*  
REGISTER OF DEEDS  
OTTAWA COUNTY, MI

For corners in  
Ottawa  
(County)

Located In: Corner Code #

1. Public Land Survey	T	7N	R	14W	I-5
	T		R		
	T		R		
	T		R		
2. Property Controlling in Section	S		T	R	
	S		T	R	
3. Miscellaneous	S		T	R	
Property in Sec.	S		T	R	

Register of Deeds Stamp & File Number

4. Lot No. \_\_\_\_\_, Recorded Plat \_\_\_\_\_  
5. Private Claims \_\_\_\_\_

A	B	C	D	E	F	G	H	I	J	K	L	M
2	6	5	4	3	2	1						
3												
4	7	8	9	10	11	12						
5												
6	18	17	16	15	14	13						
7												
8	19	20	21	22	23	24						
9												
10	30	29	28	27	26	25						
11												
12	31	32	33	34	35	36						
13												

I, Maurice J. Rosema, in a field survey on July 13, 19 93, do hereby certify that under requirements of P.A. 74, Michigan P.A. of 1970, the corner points mentioned in lines 1 and 2 above were in conformance with regulations and rules therefore as required in the current manual of survey instructions of the United States Department of the Interior, Bureau of Land Management or by a decree of a Court of Law and/or that the corner points mentioned in lines 3, 4 and 5 above were in conformance with the rules of the Michigan Board of Land Surveyors or by a Decree of a Court of Law; established, re-established, monumented, re-monumented, recovered, found as expressed below:

NOTE: Not more than 4 corners, all in the same town and range, may be recorded on this certificate.

A. Description of original monument and accessories and/or subsequent restoration:

I-5	Joiner - 1981 per L.C.R.C. recorded in Liber 4, Page 220	Tru-Line Surveying - 1985 per L.C.R.C.	Schiele - 1981 per L.C.R.C. recorded in Liber 4, Page 278
	C.I.M.	C.I.M.	2" square iron
	18" Aspen - NE 30.88'	Nail in NE side 15" Pine - SSE 73.20'	18" Aspen - NE 30.85'
	15" Pine - SE 73.20'	Nail in N side 36" Maple - WSW 59.50'	12" Pine - SE 95.95'
	36" Maple - SW 59.50'	c/1 street sign (at base) - NE 27.00'	36" Maple - SW 60.13'
	10" Aspen - NNW 58.32'	Nail in side tw 18" W Cherry - ENE 69.80'	

B. Description of corner evidence found and/or method applied in restoring or reestablishing corner:


I-5 Found C.I. monument  
Found nail in S. side tw. 20" W. Cherry - N63°E 69.78'

(NOTE: This corner was found and witnessed prior to road construction. During construction the C.I. monument was removed, I replaced it with a 5/8" x 36" steel rod and O.C. remon. cap after construction).

I hereby accept this corner as a correct and accurate perpetuation of the position of the original section corner.

C. Description of monument for corner and accessories established to perpetuate locating the position of the corner:

I-5 5/8" x 36" steel rod and O.C. remon. cap in bit. conc. road  
Set nail and O.C. remon. tag in S side tw. 20" W. Cherry - N63°E 69.78'  
Set nail and O.C. remon. tag in W side 12" Pine - N20°E 65.44'  
Centerline of street sign (at base) - N21°E 34.91'  
Set nail and O.C. remon. tag in NW side 12" Pine - S42°W 51.10'  
Set nail and O.C. remon. tag in E side 10" Pine - S40°W 102.45'  
Set nail and O.C. remon. tag in W side 12" Pine - S8°E 116.05'

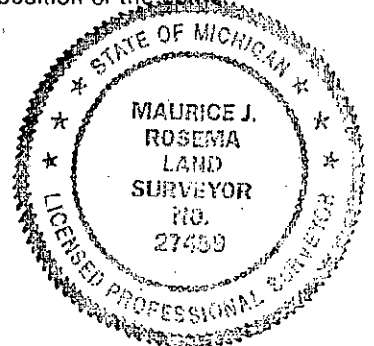

Signed by Maurice J. Rosema - Tru-Line Surveying  
Surveyor's Michigan License No. 27459

Date September 3, 1993