

Ottawa County Remonumentation

RECORDED

LAND CORNER RECORDATION CERTIFICATE
Filing Requirement of Act 74, Mich. P.A. 1970

96 DEC 18 PM 4:56

For corners in

<u>Ottawa</u> (County)	Located In:	Corner Code #
1. Public Land Survey	T <u>T7N</u> R <u>R14W</u>	I-9
	T _____ R _____	(SE cor.
	T _____ R _____	Sec. 22)
	T _____ R _____	_____
2. Property Controlling in Section	S _____ T _____ R _____	_____
	S _____ T _____ R _____	_____
3. Miscellaneous Property in Sec.	S _____ T _____ R _____	_____
	S _____ T _____ R _____	_____

D. J. ...
REGISTER OF DEEDS
OTTAWA COUNTY, MI

Register of Deeds Stamp & File Number

4. Lot No. _____, Recorded Plat _____
5. Private Claims _____

A	B	C	D	E	F	G	H	I	J	K	L	M
2	6	5	4	3	2	1						
3												
4	7	8	9	10	11	12						
5												
6	18	17	16	15	14	13						
7												
8	19	20	21	22	23	24						
9												
10	30	29	28	27	26	25						
11												
12	31	32	33	34	35	36						
13												

I, Maurice J. Rosema, in a field survey on Oct. 12, 1994, do hereby certify that under requirements of P.A. 74, Michigan P.A. of 1970, the corner points mentioned in lines 1 and 2 above were in conformance with regulations and rules therefore as required in the current manual of survey instructions of the United States Department of the Interior, Bureau of Land Management or by a decree of a Court of Law and/or that the corner points mentioned in lines 3, 4 and 5 above were in conformance with the rules of the Michigan Board of Land Surveyors or by a Decree of a Court of Law; established, re-established, monumented, re-monumented, recovered, found as expressed below:

NOTE: Not more than 4 corners, all in the same town and range, may be recorded on this certificate.

A. Description of original monument and accessories and/or subsequent restoration:

I-9	GLO - 1832 by Naoh Brookfield for Calvin Britain D.S.	L.C.R.C. recorded in Liber 3, Page 311 - Nov. 30, 1978 (over)	L.C.R.C. recorded in Liber 1, Page 441 - June 9, 1972 (over)
	25" Beech N40°E N40°E 18 lks.	L.C.R.C. recorded in Liber 2, Page 295 - Aug. 28, 1973 (over)	L.C.R.C. recorded in Liber 6, Page 157 - Oct. 11, 1991 (over)
	6" Beech S65°W 4 lks.		

B. Description of corner evidence found and/or method applied in restoring or reestablishing corner:

I-9
Found 1/2" steel rod in mon. box, replaced steel rod with 3/4" X 2' steel rod with O.C. cap
Found nail in E side P pole NW 73.07'
Found nail in E side P pole NE 64.02'
Found PK nail in NW side 20" Walnut SE 75.90'
Found nail in E side P pole SW 51.40'


P.A. 345 OTTAWA COUNTY
PEER APPROVED 12-9-96

I hereby accept this corner as a correct and accurate perpetuation of the position of the original corner.

M. J. Rosema

C. Description of monument for corner and accessories established to perpetuate locating the position of the corner:

I-9
3/4" X 2' steel rod in mon. box
Set nail and O.C. tag in E side P pole N15°W 73.07'
Set nail and O.C. tag in E side P pole N48°E 64.02'
Set nail and O.C. tag in NW side 20" Walnut S16°E 75.90'
Set nail and O.C. tag in E side P pole S32°W 51.40'
Centerline of E-W bit. conc. road N 3'
On centerline of N-S bit. conc. road

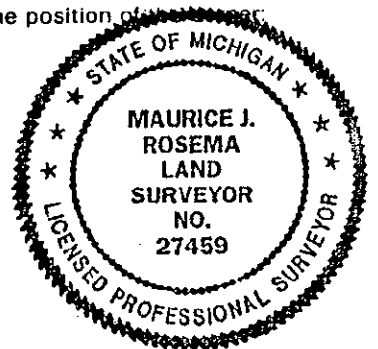

Signed by *M. J. Rosema* Date November 20, 1995
Surveyor's Michigan License No. 27459

I-9, T7N, R14W

L.C.R.C. recorded in Liber 1, Page 441

- June 9, 1972

Monument Box

Nail in face of Support Pole	NE 63.51'
Nail in face of 17" Walnut	SE 75.94'
Nail in face of Power Pole	SW 50.76'
Nail in face of Tele Pole	NW 49.70'

L.C.R.C. recorded in Liber 2, Page 295

- August 28, 1973

1/4" Iron

Nail in side P. Pole	SW 51.29'
Nail in side T. Pole	NW 50.29'
Nail in side Guy Pole	NE 63.91'

L.C.R.C. recorded in Liber 3, Page 311

- November 30, 1978

3/8" Re-Rod

18" Walnut	S18°E 75.94'
Utility Pole	S32°N 50.80'
Tel. Pole	N18°W 50.07'
Tel. Pole	N47°E 63.97'

L.C.R.C. recorded in Liber 6, Page 157

- October 11, 1991

1/2" Rod in Monument Box

Power Pole	SW 51.39'
20" Walnut	SE 76.66'
Power Pole	NE 63.96'
Power Pole	NW 73.09'