

SURVEY & REMONUMENTATION

MAR 08 1994

Ottawa County remonumentation
LAND CORNER RECORDATION CERTIFICATE
 Filing Requirement of Act 74, Mich. P.A. 1970

RECORDED

94 FEB 24 PM 2:18

For corner **COMMISSION**
 Ottawa

Richard K. Rosema
 REGISTER OF DEEDS
 OTTAWA COUNTY, MI

(County)	Located In:	Corner Code #
1. Public Land Survey	T <u>7N</u> R <u>14W</u>	<u>I-11</u>
	T _____ R _____	_____
	T _____ R _____	_____
	T _____ R _____	_____
2. Property Controlling in Section	S _____ T _____ R _____	_____
	S _____ T _____ R _____	_____
3. Miscellaneous Property in Sec.	S _____ T _____ R _____	_____
	S _____ T _____ R _____	_____

Register of Deeds Stamp & File Number

4. Lot No. _____, Recorded Plat _____
 5. Private Claims _____

	A	B	C	D	E	F	G	H	I	J	K	L	M
2	6	5	4	3	2	1							
3													
4	7	8	9	10	11	12							
5													
6	18	17	16	15	14	13							
7													
8	19	20	21	22	23	24							
9													
10	30	29	28	27	26	25							
11									●				
12	31	32	33	34	35	36							
13													

I, Maurice J. Rosema, in a field survey on July 7, 19 93, do hereby certify that under requirements of P.A. 74, Michigan P.A. of 1970, the corner points mentioned in lines 1 and 2 above were in conformance with regulations and rules therefore as required in the current manual of survey instructions of the United States Department of the Interior, Bureau of Land Management or by a decree of a Court of Law and/or that the corner points mentioned in lines 3, 4 and 5 above were in conformance with the rules of the Michigan Board of Land Surveyors or by a Decree of a Court of Law; established, re-established, monumented, re-monumented, recovered, found as expressed below:

NOTE: Not more than 4 corners, all in the same town and range, may be recorded on this certificate.

A. Description of original monument and accessories and/or subsequent restoration:

I-11 Spicer - '72 per LCRC
 3/4" iron
 MBT pole - N30°W 52.15'
 32" Maple - N18°E 47.27'
 In c/l roads N-S and E-W

Joiner - '89 per LCRC
 C.I. mon.
 PK nail in NE face P. pole - NW 87.60'
 PK nail in NW face of power box post - SW 54.65'
 PK nail in SW face P. pole - SE 81.75'
 Nail in SE face 28" Maple - NE 63.30'


B. Description of corner evidence found and/or method applied in restoring or reestablishing corner:

I-11 Found C.I. monument
 Found P.K. nail in SW side P. pole - S62°E 81.68'
 Found P.K. nail in NE side P. pole - N46°W 87.45'

I hereby accept this corner as a correct and accurate perpetuation of the position of the original section corner.

C. Description of monument for corner and accessories established to perpetuate locating the position of the corner:

I-11 Set C.I. monument box with cover around C.I. monument
 Set nail and O.C. remon. tag in SW side P. pole - S62°E 81.70'
 Set nail and O.C. remon. tag in NE side P. pole - N46°W 87.64'
 Set nail and O.C. remon. tag in S side guy pole - N84°E 100.70'
 SW corner of house (cor. of siding) - N44°E 98.24'
 SE corner of house (cor. of siding) - N54°E 129.52'
 SE corner of house (cor. of siding) - N43°W 149.68'
 At c/l x of roads N-S-E-W

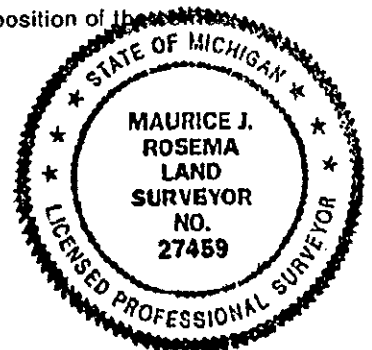

Signed by Maurice J. Rosema
 Tru-Line Surveying
 Surveyor's Michigan License No. 27459

Date February 21, 1994