

**SURVEY & REMONUMENTATION**

AUG 20 1996

**COMMISSION**

Ottawa County Remonumentation

**LAND CORNER RECORDATION CERTIFICATE**  
Filing Requirement of Act 74, Mich. P.A. 1970

RECORDED

94 DEC 15 AM 11:53

*Phyllis Anderson*  
REGISTER OF DEEDS  
OTTAWA COUNTY, MI

For corners in

<u>Ottawa</u> (County)	Located In:	Corner Code #
1. Public Land Survey	T <u>7N</u> R <u>14W</u>	<u>I-12</u>
	T _____ R _____	_____
	T _____ R _____	_____
	T _____ R _____	_____
2. Property Controlling in Section	S _____ T _____ R _____	<u>Seg #2</u>
	S _____ T _____ R _____	_____
3. Miscellaneous Property in Sec.	S _____ T _____ R _____	_____
	S _____ T _____ R _____	_____
4. Lot No. _____, Recorded Plat _____		
5. Private Claims _____		

Register of Deeds Stamp & File Number

	A	B	C	D	E	F	G	H	I	J	K	L	M
2	6	5	4	3	2	1							
3													
4	7	8	9	10	11	12							
5													
6	18	17	16	15	14	13							
7													
8	19	20	21	22	23	24							
9													
10	30	29	28	27	26	25							
11													
12	31	32	33	34	35	36							
13													

Maurice J. Rosema Oct. 15 94

I, \_\_\_\_\_, in a field survey on \_\_\_\_\_, 19\_\_\_\_\_, do hereby certify that under requirements of P.A. 74, Michigan P.A. of 1970, the corner points mentioned in lines 1 and 2 above were in conformance with regulations and rules therefore as required in the current manual of survey instructions of the United States Department of the Interior, Bureau of Land Management or by a decree of a Court of Law and/or that the corner points mentioned in lines 3, 4 and 5 above were in conformance with the rules of the Michigan Board of Land Surveyors or by a Decree of a Court of Law; established, re-established, monumented, re-monumented, recovered, found as expressed below:

**NOTE: Not more than 4 corners, all in the same town and range, may be recorded on this certificate.**

A. Description of original monument and accessories and/or subsequent restoration:  
-12

- LO - 1832 by Spicer - 1972 per L.C.R.C. Joiner - 1981 per L.C.R.C.
- oah Brookfield for rec. in L. 1, P. 817 (over) rec. in L. 4, P. 193 (over)
- alvin Britian D.S.
- " Ash - N43°W .19 ch. Rosema - 1984 per L.C.R.C. Rosema - 1993 per L.C.R.C.
- " Beech - S59°E .19 ch. rec. in L. 5, P. 162A (over) rec. in remon. L. 1, P. 204 (over)


B. Description of corner evidence found and/or method applied in restoring or reestablishing corner:  
-12

ound C.I. mon. prior to road constuction, C.I. mon. was removed during construction, laced 3/4" x 3" steel rod with std. remon. cap  
ound Nail in W. side 30" Maple - S30°E 49.38'  
ound nail in S. side 38" Box Elder - N70°E 38.04'  
ound nail in E. side Power pole - N15°W 83.21'  
ound P.K. nail in N. side 15" Pine - N83°W 43.10'  
hereby accept this corner as a correct and accurate perpetuation of the position of the original corner.

P.A. 345 OTTAWA COUNTY  
PEER APPROVED 12/12/94  
*Phyllis Anderson*

C. Description of monument for corner and accessories established to perpetuate locating the position of the corner:  
-12

- 3/4" x 3" steel rod with std. remon. cap
- et nail and remon. tag in S. side 30" Box Elder - N70°E 38.09'
- et nail and remon. tag in W. side 31" Maple - S19°E 71.13'
- et nail and remon. tag in E. side Power pole - N15°W 83.21'
- et nail and remon. tag in N. side 15" Pine - N83°W 43.10'
- et nail and remon. tag in W. side 30" Maple - S30°E 49.38'
- et nail and remon. tag in N. side 8" W. Cherry - S67°W 40.49'
- E. house cor. (cor. of siding) - N55°W 98.16'

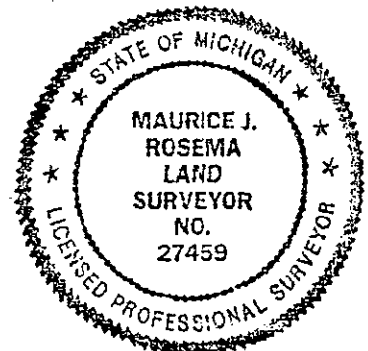

Dec. 10, 1994

Signed by *Maurice J. Rosema* Date \_\_\_\_\_  
Surveyor's Michigan License No. 27459

Part A - continued

Spicer - 1972 per L.C.R.C. rec. in L. 1, P. 817

3/4" iron

32" Maple - S33°E 49.3'

C.P. pole - N25°W 83.0'

18" Box Elder - N60°E 37.85'

Joiner - 1981 per L.C.R.C. rec. in L. 4, P. 193

C.I. mon.

29" Box Elder - NE. 36.97'

10" Pine - W. 43.13'

29" Maple - SE. 48.92'

31" Maple - SE. 71.13'

Rosema - 1984 per L.C.R.C. rec. in L. 5, P. 162A

C.I. mon.

Nail in W., side 30" Maple - S30°E 49.38'

Nail in S. side 30" Box Elder - N70°E 38.09'

Nail in E. side Power pole - N15°W 83.18'

Rosema - 1993 per L.C.R.C. rec. in remon. L. 1, P. 204

C.I. mon.

Nail and remon. tag in S. side 38" Box Elder - N70°E 38.09'

Nail and remon. tag in W. side 31" Maple - S19°E 71.12'

Nail and remon. tag in E. side Power pole - N15°W 83.21'

Nail and remon. tag in N. side 15" Pine - N83°W 43.10'

Nail and remon. tag in W. side 30" Box Elder - S30°E 49.38'

Centerline of N.-S. gravel road - E. 4'