

**SURVEY &
REMONUMENTATION**

MAR 08 1994

COMMISSION

Ottawa County remonumentation
LAND CORNER RECORDATION CERTIFICATE
Filing Requirement of Act 74, Mich. P.A. 1970

RECORDED

94 FEB 24 PM 2:18

Deborah K. Williams
REGISTER OF DEEDS
OTTAWA COUNTY, MI

For corners in

Ottawa (County)	Located In:	Corner Code #
1. Public Land Survey	T <u>7N</u> R <u>14W</u>	<u>J-11</u>
	T _____ R _____	_____
	T _____ R _____	_____
	T _____ R _____	_____
2. Property Controlling in Section	S _____ T _____ R _____	_____
	S _____ T _____ R _____	_____
3. Miscellaneous Property in Sec.	S _____ T _____ R _____	_____
	S _____ T _____ R _____	_____

Register of Deeds Stamp & File Number

4. Lot No. _____, Recorded Plat _____
5. Private Claims _____

	A	B	C	D	E	F	G	H	I	J	K	L	M
2	6	5	4	3	2	1							
3													
4	7	8	9	10	11	12							
5													
6	18	17	16	15	14	13							
7													
8	19	20	21	22	23	24							
9													
10	30	29	28	27	26	25							
11													
12	31	32	33	34	35	36							
13													

I, Maurice J. Rosema, in a field survey on July 21, 19 93, do hereby certify that under requirements of P.A. 74, Michigan P.A. of 1970, the corner points mentioned in lines 1 and 2 above were in conformance with regulations and rules therefore as required in the current manual of survey instructions of the United States Department of the Interior, Bureau of Land Management or by a decree of a Court of Law and/or that the corner points mentioned in lines 3, 4 and 5 above were in conformance with the rules of the Michigan Board of Land Surveyors or by a Decree of a Court of Law; established, re-established, monumented, re-monumented, recovered, found as expressed below:

NOTE: Not more than 4 corners, all in the same town and range, may be recorded on this certificate.

A. Description of original monument and accessories and/or subsequent restoration:

J-11 Englert - '73 per LCRC 5/8" rod
T.P. - SE 46.83'
P.P. - NE 43.83'
G.P. - NW 32.68'

Greer - '74 per LCRC Steel bar
Guy Pole - NW 32.70'
30" Maple - NW 100.18'
P.P. - NE 43.83'
St. sign - SE 46.70'
Tele. pole - SE 46.85'

Tru-Line - '85 per LCRC 5/8" steel rod
PK in NW side P. pole - NE 44.54'
PK in SW side guy pole - NW 33.54'
Centerline base of St. sign - SE 46.79'
Centerline of N-S gravel road - E 3'
On centerline of E-W gravel road

B. Description of corner evidence found and/or method applied in restoring or reestablishing corner:


J-11 Found C.I. monument
Found PK nail in SW side guy pole - N40°W 33.55'
Found PK nail in NW side P. pole - N37°E 44.54'
Centerline of Street sign - S53°E 46.90'
Found nail in SW side 15" Pine - S20°E 80.19'

Joiner - '89 per LCRC
C.I. mon.
PK in SW face utility pole - NW 33.55'
Nail in SW face 10" Pine - SW 80.26'
PK in SW face wooden T.P. - SW 46.78'
Nail in SE face utility pole - NE 44.38'

I hereby accept this corner as a correct and accurate perpetuation of the position of the original section corner.

C. Description of monument for corner and accessories established to perpetuate locating the position of the corner:

J-11 Set C.I. monument box with cover around C.I. monument
SW house corner (fndn.) - S33°E 159.75'
NW house corner (cor. of brick) - S52°E 125.45'
Set nail and O.C. remon. tag in SW side 15" Pine - S20°E 80.19'
Set nail and O.C. remon. tag in SW side guy pole - N37°W 46.48'
Set nail and O.C. remon. tag in NW side P. pole - N39°E 49.55'
At c/l x roads N-S-E-W

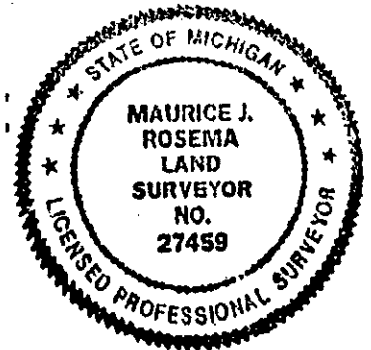

Signed by *Maurice J. Rosema*
Tru-Line Surveying
Surveyor's Michigan License No. 27459

Date February 21, 1994