

RECORDED

RECORDED

93 DEC 15 AM 9:28

COMMISSION

Ottawa County remonumentation
LAND CORNER RECORDATION CERTIFICATE

Filing Requirement of Act 74, Mich. P.A. 1970

D. J. Blom
REGISTER OF DEEDS
OTTAWA COUNTY, MI

For corners in

Ottawa (County)	Located In:	Corner Code #
1. Public Land Survey	T <u>7N</u> R <u>14W</u>	<u>J-13</u>
	T _____ R _____	_____
	T _____ R _____	_____
	T _____ R _____	_____
2. Property Controlling in Section	S _____ T _____ R _____	_____
	S _____ T _____ R _____	_____
3. Miscellaneous Property in Sec.	S _____ T _____ R _____	_____
	S _____ T _____ R _____	_____

Register of Deeds Stamp & File Number

- 4. Lot No. _____, Recorded Plat _____
- 5. Private Claims _____

	A	B	C	D	E	F	G	H	I	J	K	L	M
2	6	5	4	3	2	1							
3													
4	7	8	9	10	11	12							
5													
6	18	17	16	15	14	13							
7													
8	19	20	21	22	23	24							
9													
10	30	29	28	27	26	25							
11													
12	31	32	33	34	35	36							
13													

I, Maurice J. Rosema, in a field survey on Aug. 2, 1993, do hereby certify that under requirements of P.A. 74, Michigan P.A. of 1970, the corner points mentioned in lines 1 and 2 above were in conformance with regulations and rules therefore as required in the current manual of survey instructions of the United States Department of the Interior, Bureau of Land Management or by a decree of a Court of Law and/or that the corner points mentioned in lines 3, 4 and 5 above were in conformance with the rules of the Michigan Board of Land Surveyors or by a Decree of a Court of Law; established, re-established, monumented, re-monumented, recovered, found as expressed below:

NOTE: Not more than 4 corners, all in the same town and range, may be recorded on this certificate.

A. Description of original monument and accessories and/or subsequent restoration:

J-13 Exxel - 1974 per L.C.R.C.
 recorded in Liber 2, Page 501
 1/2" iron
 Spk. with blaze on side P. pole - S 115.67'
 Spk. with blaze on side of fc. cor. post - N. 27.27'
 Spk. with flag on N. side Tri. 8" Maple - WSW. 113.5'
 On line with fence to N.
 Joiner - 1981 per L.C.R.C. rec. in Liber 4, Page 193
 C.I.M. P. pole - N. 30.08' Fc. post - S. 36.26' 7" tree
 SE. 39.90' Blendon cor. - W. 3.61'


Prein and Newhof per
 L.C.R.C. recorded in
 Liber 6, Page 207
 C.I.M.
 SW. cor. 6' x 12' conc.
 box culv. - S75°E 129.91'
 NW. cor. 6' x 12' conc.
 box culv. - N75°E 157.97'
 Nail and tag in W. side
 P. pole - N5°W 30.19'
 P.K. in top of 4" post - S80°W 84.0
 Nail and tag in SW. side 8" Box
 Elder - S15°E 38.85'
 Blendon Corner - W. 3.60'

B. Description of corner evidence found and/or method applied in restoring or reestablishing corner:
J-13 Found C.I. monument in mon. box
 Blendon cor. (C.I. mon. in mon. box) - S90°W 3.64'
 Found nail and tag in W. side P. pole - N5°W 30.19'
 Found P.K. nail in top of T. box post - S75°W 84.07'
 SW. cor. 6' x 12' conc. box culv. - S75°E 129.94'
 NW. cor. 6' x 12' conc. box culv. - N80°E 158.03'
 Found nail and tag in SW. side 9" Box Elder - S22°E 38.76'

I hereby accept this corner as a correct and accurate perpetuation of the position of the original section corner.

C. Description of monument for corner and accessories established to perpetuate locating the position of the corner:

J-13 Set O.C. remon. cap in conc. above C.I. mon. in mon. box
 Set nail and O.C. remon. tag in W. side P. pole - N5°W 30.19'
 Set nail and O.C. remon. tag in top of T. box post - S75°W 84.07'
 Set nail and O.C. remon. tag in SW side 9" Box Elder - S22°E 38.76'
 SW. cor. 6' x 12' conc. box culv. - S75°E 129.94'
 NW. cor. 6' x 12' conc. box culv. - N80°E 158.03'
 Blendon cor. (C.I. mon. in mon. box) - S90°W 3.64'
 on centerline of E-W bit. conc. road

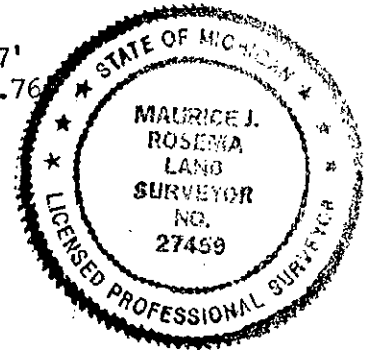

Signed by *Maurice J. Rosema* Date Sept. 3, 1993
 Surveyor's Michigan License No. 27459