

**SURVEY &
REMONUMENTATION**

OTTAWA COUNTY REMONUMENTATION

APR 05 1996

LAND CORNER RECORDATION CERTIFICATE

COMMISSION Filing Requirement of Act 74, Mich. P.A. 1970

For corners in
Ottawa _____
(County)

Located In:

Corner Code #

- | | | |
|------------------------------------|---------|-----------------|
| 1. Public Land Survey | T7N | R14W |
| | T _____ | R _____ |
| | T _____ | R _____ |
| | T _____ | R _____ |
| 2. Property Controlling in Section | S _____ | T _____ R _____ |
| | S _____ | T _____ R _____ |
| 3. Miscellaneous Property in Sec. | S _____ | T _____ R _____ |
| | S _____ | T _____ R _____ |

K-1
NW cor. Sec. 1,
T7N, R14W

Common corner
w/ K-13
Polkton Twp.

RECORDED

95 NOV 29 PM 1:34

Richard R. Williams
REGISTER OF DEEDS
OTTAWA COUNTY, MI

Register of Deeds Stamp & File Number

4. Lot No. _____, Recorded Plat _____
5. Private Claims _____

I, Steven Lampen _____, in a field survey on November 15 1995, do hereby certify that under requirements of P.A. 74, Michigan P.A. of 1970, the corner points mentioned in lines 1 and 2 above were in conformance with regulations and rules therefore as required in the current manual of survey instructions of the United States Department of the Interior, Bureau of Land Management or by a decree of a Court of Law and/or that the corner points mentioned in lines 3, 4 and 5 above were in conformance with the rules of the Michigan Board of Land Surveyors or by a Decree of a Court of Law, established, re-established, monumented, re-monumented, recovered, found as expressed below:

NOTE: Not more than 4 corners, all in the same town and range, may be recorded on this certificate.

A. Description of original monument and accessories and/or subsequent restoration:

K-1 GLO Survey Notes 1837, Surveyor - John Mullett Intersected North boundary at post 8" Beech S 23° W 9 links 10" Beech S 11° E 27 links	K-1 Old Records of JK & A Found steel bar used by Englert in 1973 9" Maple N 2.90' 13" Maple NW 14.35' 10" Maple S 5.0'
--	--

K-1 LCRC L 2-P 261 August 6, 1973 5/8" rod in fence corner 9" Maple N 9.90' 13" Maple NW 14.35' 10" Maple S 5.00'	K-1 LCRC L 4-P 48, April 14, 1980 Found iron, set cast iron mon. 9" Maple N 2.90' 13" Maple NW 14.45' 14" Maple ENE 24.18' 14" Maple SE 24.75'
---	--

B. Description of corner evidence found and/or method applied in restoring or reestablishing corner:

K-1
Found cast iron monument
11" Maple AZ 0° 3'±
15" Maple AZ 180° 5'±
Nail & tag R.L.S. #14091 N face 18" Maple AZ 144° 24.67'
Nail & tag R.L.S. #14091 S face 16" Maple AZ 80° 24.09'
Face of 14" Maple AZ 306° 14.5'±
E-W fence line to W
N-S fence line to N
Accepted cast iron monument as a careful and faithful perpetuation of the position of the original corner.

C. Description of monument for corner and accessories established to perpetuate locating the position of the corner:


K-1
Cast iron monument
O. C. Remonumentation tag & nail E face 24" Maple AZ 350 32.27'
O. C. Remon. tag & nail N face 18" Maple AZ 144° 25.27'
O. C. Remon. tag & nail S face 16" Maple AZ 80° 24.95'
O. C. Remon. tag & nail E face 15" Maple AZ 180° 4.74'

1	A	B	C	D	E	F	G	H	I	J	K	L	M
2	6	5	4	3	2	1							
3													
4	7	8	9	10	11	12							
5													
6	18	17	16	15	14	13							
7													
8	19	20	21	22	23	24							
9													
10	30	29	28	27	26	25							
11													
12	31	32	33	34	35	36							
13													

K-1
Survey in L 8-P 192
Found cast iron mon.
10" Cherry N 49° E 15.44'
15" Maple N 80° E 24.16'
15" Maple S 42° E 24.70'
10" Maple S 30° W 5.21'

P.A. 345 OTTAWA COUNTY
PEER APPROVED 11/20/95

Richard R. Williams

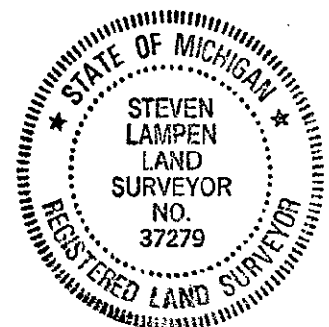

Signed by Steven Lampen

Date November 17, 1995

Surveyor's Michigan License No. 37279