

**SURVEY &
REMONUMENTATION**

APR 05 1996

Ottawa County Remonumentation

LAND CORNER RECORDATION CERTIFICATE

RECORDED

95 DEC 12 PM 4: 51

COMMISSION

Filing Requirement of Act 74, Mich. P.A. 1970

For corners in

<u>Ottawa</u> <small>(County)</small>	Located in:	Corner Code #
1. Public Land Survey	T <u>T7N</u> R <u>R14W</u>	K-4
	T _____ R _____	_____
	T _____ R _____	_____
	T _____ R _____	_____
2. Property Controlling in Section	S _____ T _____ R _____	_____
	S _____ T _____ R _____	_____
3. Miscellaneous Property in Sec.	S _____ T _____ R _____	_____
	S _____ T _____ R _____	_____
4. Lot No. _____, Recorded Plat _____		
5. Private Claims _____		

Phyllis Williams
REGISTER OF DEEDS
OTTAWA COUNTY, MI

Register of Deeds Stamp & File Number

Maurice J. Rosema in a field survey on April 22, 1995

do hereby certify that under requirements of P.A. 74, Michigan P.A. of 1970, the corner points mentioned in lines 1 and 2 above were in conformance with regulations and rules therefore as required in the current manual of survey instructions of the United States Department of the Interior, Bureau of Land Management or by a decree of a Court of Law and/or that the corner points mentioned in lines 3, 4 and 5 above were in conformance with the rules of the Michigan Board of Land Surveyors or by a Decree of a Court of Law; established, re-established, monumented, re-monumented, recovered, found as expressed below:

NOTE: Not more than 4 corners, all in the same town and range, may be recorded on this certificate.

A. Description of original monument and accessories and/or subsequent restoration:

K-4	L.C.R.C. recorded in Liber 1,
GLO - 1837 by	Page 237 - Jan. 31, 1972
John Mullett D.S.	1" Iron
Set Post	Nail in SE side double W Cherry SW 50.86'
20" Pine S21°E 33 lks.	Nail in NE side 8" Oak SNW 27.33'
20" Pine N66°W 56 lks.	Nail in N side 12" Oak W 34.45'
	On line with fence and tree line to W, trail to N and field line to S

B. Description of corner evidence found and/or method applied in restoring or reestablishing corner:

K-4
Found 1/2" iron pipe, replaced with 3/4" X 3' steel rod with O.C. cap (1' deep) on field division N-S
All other wit. are gone but location checks with survey map by Campbell RLS and info. from the files of Tru-Line Surveying P.C.


I hereby accept this corner as a correct and accurate perpetuation of the position of the original corner,

P.A. 345 OTTAWA COUNTY
PEER APPROVED 12/11/95

Murray D. Hedewold
M.D.

C. Description of monument for corner and accessories established to perpetuate locating the position of the corner:

K-4	
3/4" X 3' steel rod with O.C. cap	
Set nail and O.C. tag in W side 12" Walnut	N4°W 735.21'
Set nail and O.C. tag in W side 15" Walnut	N8°E 922.44'
Set nail and O.C. tag in W side 15" Elm	N0°W 845.39'
SE cor. house (cor. of brick)	N13°W 777.98'
SE cor. of metal shed	N20°W 706.96'
SW cor. of metal shed	N23°W 694.07'

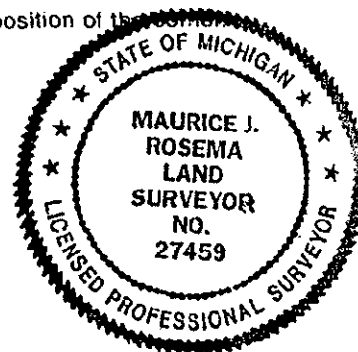

Signed by *Maurice J. Rosema* Date November 20, 1995
Surveyor's Michigan License No. 27459

FORM APPROVED BY MICHIGAN STATE BOARD OF LAND SURVEYORS, JAN. 28, REVISED MAY 14, REVISED JAN. .