

SURVEY & REMONUMENTATION

APR 24 1995

Ottawa County Remonumentation
LAND CORNER RECORDATION CERTIFICATE
 Filing Requirement of Act 74, Mich. P.A. 1970

RECORDED

94 DEC 15 AM 11:54

For corner of **COMMISSION**
 Ottawa

Phyllis Robinson
 REGISTER OF DEEDS
 OTTAWA COUNTY, MI

(County)	Located In:	Corner Code #
1. Public Land Survey	T <u>7N</u> R <u>14W</u>	<u>K-6</u>
	T _____ R _____	_____
	T _____ R _____	_____
	T _____ R _____	_____
2. Property Controlling in Section	S _____ T _____ R _____	_____
	S _____ T _____ R _____	_____
3. Miscellaneous Property in Sec.	S _____ T _____ R _____	_____
	S _____ T _____ R _____	_____

Register of Deeds Stamp & File Number

4. Lot No. _____, Recorded Plat _____
 5. Private Claims _____

	A	B	C	D	E	F	G	H	I	J	K	L	M
2	6	5	4	3	2	1							
3													
4	7	8	9	10	11	12							
5													
6	18	17	16	15	14	13							
7													
8	19	20	21	22	23	24							
9													
10	30	29	28	27	26	25							
11													
12	31	32	33	34	35	36							
13													

Maurice J.

I, Rosema, in a field survey on Oct. 11, 19 94, do hereby certify that under requirements of P.A. 74, Michigan P.A. of 1970, the corner points mentioned in lines 1 and 2 above were in conformance with regulations and rules therefore as required in the current manual of survey instructions of the United States Department of the Interior, Bureau of Land Management or by a decree of a Court of Law and/or that the corner points mentioned in lines 3, 4 and 5 above were in conformance with the rules of the Michigan Board of Land Surveyors or by a Decree of a Court of Law; established, re-established, monumented, re-monumented, recovered, found as expressed below:

NOTE: Not more than 4 corners, all in the same town and range, may be recorded on this certificate.

A. Description of original monument and accessories and/or subsequent restoration:
 K-6

GLO - 1832 by Noah Brookfield for Calvin Britain D.S.
 10" Sugar - N51°E .8 ch.
 20" Beech - S27°W .12 ch.

Roon - 1972 per L.C.R.C. rec. in L. 1, P 657 (over)
 Joiner - 1981 per L.C.R.C. rec. in L. 4, P. 289 (over)

B. Description of corner evidence found and/or method applied in restoring or reestablishing corner:


K-6
 Found C.I. mon. (0.4' below grade)
 Found nail in SE. side wood post at tele. ped. - S71°W 57.90'
 Found nail in SW. side of Power pole - S65°E 89.15'
 Centerline of street sign post - N. 20.14'

I hereby accept this corner as a correct and accurate perpetuation of the position of the original corner.

P.A. 345 OTTAWA COUNTY
 PEER APPROVED 12/12/94
Phyllis Robinson

C. Description of monument for corner and accessories established to perpetuate locating the position of the corner:

K-6
 C.I. mon.
 Set nail and remon. tag in SE. side wood post at tele. ped. - N71°W 57.90'
 Set nail and remon. tag in SW. side Power pole - S65°E 89.15'
 Set nail and remon. tag in S. side 13" Maple - N39°W 61.08'
 Set nail and remon. tag in NE. side Power pole - S74°W 126.31'

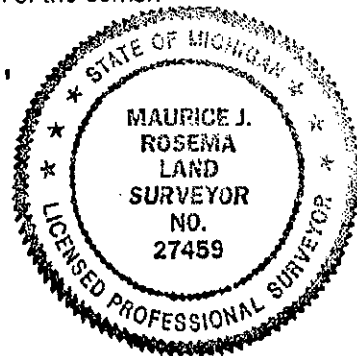

Signed by Maurice J. Rosema
 Surveyor's Michigan License No. 27459

Date Dec. 10, 1994

Part A - continued

Roon - 1972 per L.C.R.C. rec. in L. 1, P. 657
C.I. mon.

Nail in face of tw. 28" Maple - SW. 49.36'

Nail in face of 34" Pine - SE. 84.90'

Nail in face of 9" Walnut - ENE. 78.30'

1' W. of c/1 104th Ave.

Joiner - 1981 per L.C.R.C. rec. in L. 4, P. 289
C.I. mon.

Power pole - ESE. 89.13'

Wood post near tele. ped. - Sw. 57.95'

12" Maple - NW. 61.08'

Street sign - N. 20.43'


