

Ottawa County Remonumentation  
**LAND CORNER RECORDATION CERTIFICATE**  
 Filing Requirement of Act 74, Mich. P.A. 1970

RECORDED

96 DEC 18 PM 4:56

For corners in

<u>Ottawa</u> <small>(County)</small>	Located In:	Corner Code #
1. Public Land Survey	T <u>T7N</u> R <u>R14W</u>	K-8
	T _____ R _____	(E <sub>4</sub> cor.)
	T _____ R _____	Sec. 23)
	T _____ R _____	
2. Property Controlling in Section	S _____ T _____ R _____	
	S _____ T _____ R _____	
3. Miscellaneous Property in Sec.	S _____ T _____ R _____	
	S _____ T _____ R _____	

*Edythe R. Carlstrom*  
 REGISTER OF DEEDS  
 OTTAWA COUNTY, MI  
**SURVEY &  
 REMONUMENTATION**  
 DEC 05 2000  
 SECTION \_\_\_\_\_  
 Register of Deeds Stamp & File Number

4. Lot No. \_\_\_\_\_, Recorded Plat \_\_\_\_\_  
 5. Private Claims \_\_\_\_\_

	A	B	C	D	E	F	G	H	I	J	K	L	M
2	6	5	4	3	2								
3													
4	7	8	9	10	11	12							
5													
6	18	17	16	15	14	13							
7													
8	19	20	21	22	23	24							
9													
10	30	29	28	27	26	25							
11													
12	31	32	33	34	35	36							

I, Maurice J. Rosema, in a field survey on Oct. 11, 1994, do hereby certify that under requirements of P.A. 74, Michigan P.A. of 1970, the corner points mentioned in lines 1 and 2 above were in conformance with regulations and rules therefore as required in the current manual of survey instructions of the United States Department of the Interior, Bureau of Land Management or by a decree of a Court of Law and/or that the corner points mentioned in lines 3, 4 and 5 above were in conformance with the rules of the Michigan Board of Land Surveyors or by a Decree of a Court of Law; established, re-established, monumented, re-monumented, recovered, found as expressed below:

**NOTE: Not more than 4 corners, all in the same town and range, may be recorded on this certificate.**

A. Description of original monument and accessories and/or subsequent restoration:

K-8	Glo - 1832 (Noah Brookfield D.S.)	L.C.R.C. recorded in Liber 4	L.C.R.C.
	9" Pine N80°W 12 lks	Page 214 - Aug. 21, 1981 (over)	recorded in Liber
	10" Pine N85°E 14 lks		5 Page 199 - Feb.
		L.C.R.C. recorded in Liber 1	15, 1985 (over)
	L.C.R.C. recorded in Liber 1	Page 769 - Sept. 1 1972 (over)	
	Page 441 - June 7, 1972 (over)		
		L.C.R.C. recorded in Liber 4	
		Page 290 - Dec. 29, 1981 (over)	

B. Description of corner evidence found and/or method applied in restoring or reestablishing corner:

K-8  
 Found C.I. monument  
 Found PK in P.pole S48°E 64.25'  
 Found PK in P.Pole S70°W 66.86'


P.A. 345 OTTAWA COUNTY  
 PEER APPROVED 12-9-96

*M.J.R.*

I hereby accept this corner as a correct and accurate perpetuation of the position of the original corner.

C. Description of monument for corner and accessories established to perpetuate locating the position of the corner:

K-8	C.I. mon. in mon. box	S48°E 64.25'
	Set nail and O.C. tag in NW side P pole	S70°W 66.86'
	Set nail and O.C. tag in NW side P pole	N85°W 48.72'
	Set nail and O.C. tag in N side 10" Ash	S67°E 55.33'
	Set nail and O.C. tag in top of wood post	S29°W 83.33'
	Set nail and O.C. tag in N side 12" Ash	
	On centerline of N-S bit. conc. road	
	On centerline of gravel road to E	

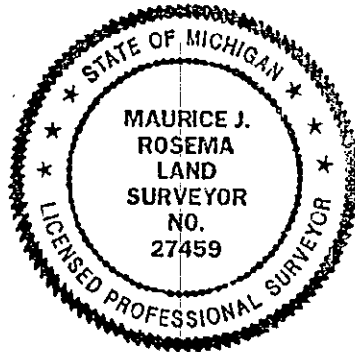

Signed by *M. J. Rosema* Date October 21, 1995  
 Surveyor's Michigan License No. 27459

FORM APPROVED BY MICHIGAN STATE BOARD OF LAND SURVEYORS, JAN. 28, 1971  
 REVISED MAY 14, 1975  
 REVISED JAN., 1983

K-8 T7N R14W

L.C.R.C. recorded in Liber 1, Page 441  
- June 9, 1972

Iron  
Nail in face of Tele. pole NE 42.05'  
Nail in face of Power pole SE 64.13'  
Nail in face of Tele. pole W 34.23'  
Nail in face of Street sign W 19.15'

L.C.R.C. recorded in Liber 1, Page 760  
- November 21, 1972

1" Iron  
Nail in side Tele. pole W 31.82'  
Nail in side Tele. pole NE 44.39'  
Nail in side P. pole NNE 170.68'  
Nail in side P. pole SE 66.80'

L.C.R.C. recorded in Liber 4, Page 214  
- August 31, 1981

Angle Iron  
Nail in N side 6" Ash W 48.77'  
PK in NW side P. pole WSW 66.86'  
PK in NW side P. pole SE 64.12'  
PK in W side P. pole NNE 169.57'  
On Centerline N-S and East

L.C.R.C. recorded in Liber 4, Page 290  
- January 5, 1982

C.I. Monument  
Power pole SE 64.67'  
Tele. pole SW 66.92'  
6" Ash W 48.84'  
4" Ash SW 83.95'

L.C.R.C. recorded in Liber 5, Page 199  
- February 20, 1985

C.I. Monument  
1/2" Iron W 2.85'  
Nail in N side 6" Ash W 48.80'  
PK in NW side P. pole SE 64.16'  
PK in W side P. pole NNE 169.56'  
PK in NW side P. pole WSW 66.90'