

Ottawa County Remonumentation
LAND CORNER RECORDATION CERTIFICATE
 Filing Requirement of Act 74, Mich. P.A. 1970

RECORDED

96 DEC 18 PM 4: 56

For corners in

<u>Ottawa</u> <small>(County)</small>	Located In:	Corner Code #
1. Public Land Survey	T <u>T7N</u> R <u>R14W</u>	K-9
	T _____ R _____	(SE cor.
	T _____ R _____	Sec. 23)
	T _____ R _____	_____
2. Property Controlling in Section	S _____ T _____ R _____	_____
	S _____ T _____ R _____	_____
3. Miscellaneous Property in Sec.	S _____ T _____ R _____	_____
	S _____ T _____ R _____	_____
4. Lot No. _____, Recorded Plat _____		
5. Private Claims _____		

D. J. ...
 REGISTER OF DEEDS
 OTTAWA COUNTY, MI

Register of Deeds Stamp & File Number

I, Maurice J. Rosema, in a field survey on Oct. 12, 19 94,

do hereby certify that under requirements of P.A. 74, Michigan P.A. of 1970, the corner points mentioned in lines 1 and 2 above were in conformance with regulations and rules therefor as required in the current manual of survey instructions of the United States Department of the Interior, Bureau of Land Management or by a decree of a Court of Law and/or that the corner points mentioned in lines 3, 4 and 5 above were in conformance with the rules of the Michigan Board of Land Surveyors or by a Decree of a Court of Law; established, re-established, monumented, re-monumented, recovered, found as expressed below:

A	B	C	D	E	F	G	H	I	J	K	L	M
2	6	5	4	3	2	1						
3												
4	7	8	9	10	11	12						
5												
6	18	17	16	15	14	13						
7												
8	19	20	21	22	23	24						
9												
10	30	29	28	27	26	25						
11												
12	31	32	33	34	35	36						
13												

NOTE: Not more than 4 corners, all in the same town and range, may be recorded on this certificate.

A. Description of original monument and accessories and/or subsequent restoration:

- K-9
 Glo - 1832 (Noah Brookfield D.S.) L.C.R.C. recorded in Liber 5
 20" Sugar S32°E 9 lks Page 199 - Feb. 15, 1985 (over)
 18" Beech N34°W 39 lks
 L.C.R.C. recorded in Liber 1
 Page 441 - June 7, 1972 (over)
 L.C.R.C. recorded in Liber 6
 Page 162 - Sept. 13, 1991

B. Description of corner evidence found and/or method applied in restoring or reestablishing corner:

- K-9
 Found 1" Solid Rod in Mon Box Replaced with 3/4" x 2' Steel bar with
 Ottawa County remon. cap
 Found PK in P.Pole SW 56.81'


P.A. 345 OTTAWA COUNTY
 PEER APPROVED 12-9-96

M. J. Rosema

I hereby accept this corner as a correct and accurate perpetuation of the position of the original corner.

C. Description of monument for corner and accessories established to perpetuate locating the position of the corner:

- K-9
 3/4" X 2' steel bar with Ottawa County remon. cap
 Set nail and O.C. tag in W side P pole N42°E 56.63'
 Set nail and O.C. tag in W side P pole S40°W 56.81'
 Set nail and O.C. tag in NW side tri 14" Maple S52°W 95.60'
 Set nail and O.C. tag in wood post for sign N68°E 83.97'
 On c/l N-S bit. conc. road S 1'
 c/l E-W bit. conc. road

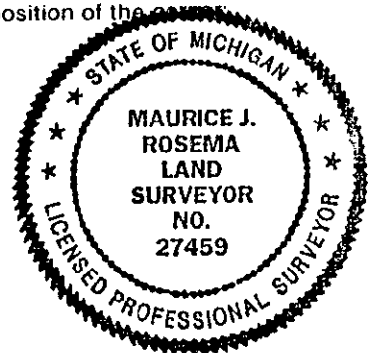

Signed by *M. J. Rosema*
 Surveyor's Michigan License No. 27459

Date Nov. 20, 1995

K-9 T7N R14W

L.C.R.C. recorded in Liber 1, Page 441
- June 9, 1972

Monument Box
Nail in face of Power pole NE 56.40'
Nail in face of Power pole SW 54.40'
Nail in face of Street sign NW 36.60'
Building Corner SE 53.90'

L.C.R.C. recorded in Liber 5, Page 199
- February 20, 1985

1" Solid Rod in Monument Box
PK in face P. pole NE 56.29'
Street sign NW 36.60'
PK in face P. pole SW 54.70'
NW cor fndn. bldg. SE 54.73'

L.C.R.C. recorded in Liber 6, Page 162
- October 11, 1991

1" Iron in Monument Box
SE to bldg cor 6" Ash 53.94'
Power pole SW 56.95'
36" Willow NW 98.10'
Power pole NE 56.17'