

SURVEY & REMONUMENTATION

MAR 08 1994

COMMISSION

Ottawa County remonumentation
LAND CORNER RECORDATION CERTIFICATE
 Filing Requirement of Act 74, Mich. P.A. 1970

RECORDED

94 FEB 24 PM 2:18

D. J. Rosema
 REGISTER OF DEEDS
 OTTAWA COUNTY, MI

For corners in
 Ottawa

(County)	Located In:	Corner Code #
1. Public Land Survey	T <u>7N</u> R <u>14W</u>	<u>K-10</u>
	T _____ R _____	_____
	T _____ R _____	_____
	T _____ R _____	_____
2. Property Controlling in Section	S _____ T _____ R _____	_____
	S _____ T _____ R _____	_____
3. Miscellaneous Property in Sec.	S _____ T _____ R _____	_____
	S _____ T _____ R _____	_____
4. Lot No. _____, Recorded Plat _____		
5. Private Claims _____		

Register of Deeds Stamp & File Number

	A	B	C	D	E	F	G	H	I	J	K	L	M
2	6	5	4	3	2	1							
3													
4	7	8	9	10	11	12							
5													
6	18	17	16	15	14	13							
7													
8	19	20	21	22	23	24							
9													
10	30	29	28	27	26	25							
11													
12	31	32	33	34	35	36							
13													

I, Maurice J. Rosema, in a field survey on Oct. 29, 19 93, do hereby certify that under requirements of P.A. 74, Michigan P.A. of 1970, the corner points mentioned in lines 1 and 2 above were in conformance with regulations and rules therefore as required in the current manual of survey instructions of the United States Department of the Interior, Bureau of Land Management or by a decree of a Court of Law and/or that the corner points mentioned in lines 3, 4 and 5 above were in conformance with the rules of the Michigan Board of Land Surveyors or by a Decree of a Court of Law; established, re-established, monumented, re-monumented, recovered, found as expressed below:

NOTE: Not more than 4 corners, all in the same town and range, may be recorded on this certificate.

A. Description of original monument and accessories and/or subsequent restoration:

K-10 Greer - '74 per LCRC
 Tele. pole - S30°E 63.95'
 Tele. pole - N20°E 85.80'
 Angle iron - W 33.00'
 Power pole - W 110.40'

Tru-Line - '88
 C.I. mon.
 Nail and tag in S side P. pole - W 110.61'
 Angle iron - W 32.98'
 3rd post S of fence corner - SE 56.30'
 Fence to E - S 18'


B. Description of corner evidence found and/or method applied in restoring or reestablishing corner:

K-10 Found C.I. mon. (prior to construction), set 3/4" steel rod and standard O.C. cap (after construction) in it's place
 Found capped rerod - S87°E 32.92'
 Found nail and tag in S side P. pole - N87°W 110.70'

I hereby accept this corner as a correct and accurate perpetuation of the position of the original section corner.

C. Description of monument for corner and accessories established to perpetuate locating the position of the corner:

K-10 Set 3/4" steel rod and standard O.C. remon. cap in C.I. mon. box with cover
 Set PK nail in top of plastic culvert at N end - S36°E 43.36'
 Set PK nail in top of plastic culvert at S end - S18°E 69.25'
 Face of 0.4' dia. steel post - N31°W 38.10'
 Capped rerod - S87°E 32.92'
 Set nail and O.C. remon. tag in S side P. pole - N87°W 110.70'
 On c/l N-S bit. conc. road

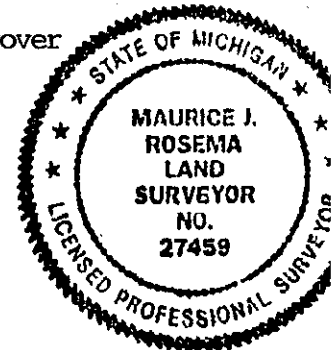

Signed by *Maurice J. Rosema*
 Surveyor's Michigan License No. 27459

Date February 21, 1994