

RECORDED

93 DEC 15 AM 9:31

Ottawa County remonumentation  
LAND CORNER RECORDATION CERTIFICATE  
Filing Requirement of Act 74, Mich. P.A. 1970

*Maurice J. Rosema*  
REGISTER OF DEEDS  
OTTAWA COUNTY, MI

For corners in

<u>Ottawa</u> (County)	Located In:	Corner Code #
1. Public Land Survey	T <u>7N</u> R <u>14W</u>	<u>K-11</u>
	T _____ R _____	_____
	T _____ R _____	_____
	T _____ R _____	_____
2. Property Controlling in Section	S _____ T _____ R _____	_____
	S _____ T _____ R _____	_____
3. Miscellaneous Property in Sec.	S _____ T _____ R _____	_____
	S _____ T _____ R _____	_____
4. Lot No. _____, Recorded Plat _____		
5. Private Claims _____		

Register of Deeds Stamp & File Number

I, Maurice J. Rosema, in a field survey on July 21, 1993, do hereby certify that under requirements of P.A. 74, Michigan P.A. of 1970, the corner points mentioned in lines 1 and 2 above were in conformance with regulations and rules therefore as required in the current manual of survey instructions of the United States Department of the Interior, Bureau of Land Management or by a decree of a Court of Law and/or that the corner points mentioned in lines 3, 4 and 5 above were in conformance with the rules of the Michigan Board of Land Surveyors or by a Decree of a Court of Law; established, re-established, monumented, re-monumented, recovered, found as expressed below:

**NOTE: Not more than 4 corners, all in the same town and range, may be recorded on this certificate.**

A. Description of original monument and accessories and/or subsequent restoration:

<b>K-11</b> Englert - 1973 per L.C.R.C recorded in L. 2, P. 247 1" pipe T.P. - SW 50.35' St. sign - SE 44.80'	<b>Greer</b> - 1974 per L.C.R.C. recorded in L. 2, P. 589 Iron post and fence post base T.P. - S15°W 49.50' Sign post - S40°E 44.70' E. end conc. culv. - NE 33.75' W. end conc. culv. - NW 30.60' T. pole - SW 50.35'
--	--

**Joiner** - 1989 per L.C.R.C. recorded in L. 5, P. 370  
C.I.M.  
P.K. nail in NW face P. Pole NE 130.16'  
Chisled X cut in culv. - NW 49.54'  
Nail in NW face P. box post - SW 50.31'  
Chisled X cut in culv. - SE 58.00'


B. Description of corner evidence found and/or method applied in restoring or reestablishing corner.

**K-11** Found C.I.M. in mon. box  
Found P.K. nail in NW side P. pole - N54°E 130.16'

I hereby accept this corner as a correct and accurate perpetuation of the position of the original section corner.

C. Description of monument for corner and accessories established to perpetuate locating the position of the corner:

**K-11** Found C.I.M. in mon. box  
Centerline base of street sign post - S50°W 47.80'  
Set nail and O.C. remon. tag in W side 17" Maple - N10°W 163.26'  
SE gar. corner (corner of siding) - N31°W 199.35'  
Set nail and O.C. remon. tag in NW side P. pole - N54°E 130.16'  
Set nail and O.C. remon. tag in SW side P. pole - N50°W 124.00'  
At centerline "x" of bit. conc. roads E-W-N-S

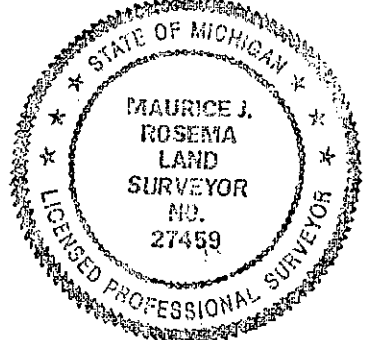

Signed by *Maurice J. Rosema*  
Surveyor's Michigan License No. 27459

Date December 6, 1993