

Ottawa County remonumentation
LAND CORNER RECORDATION CERTIFICATE
 Filing Requirement of Act 74, Mich. P.A. 1970

RECORDED
 94 DEC -8 PM 12:31

Rosema
 REGISTER OF DEEDS
 OTTAWA COUNTY, MI
**SURVEY &
 REMONUMENTATION**

DEC 05 2000

SECTION

Register of Deeds Stamp & File Number

For corners in Ottawa (County)	Located In:	Corner Code #
1. Public Land Survey	T <u>7N</u> R <u>14W</u>	<u>K-12</u>
	T _____ R _____	_____
	T _____ R _____	_____
	T _____ R _____	_____
2. Property Controlling in Section	S _____ T _____ R _____	_____
	S _____ T _____ R _____	_____
3. Miscellaneous Property in Sec.	S _____ T _____ R _____	_____
	S _____ T _____ R _____	_____

4. Lot No. _____, Recorded Plat _____
 5. Private Claims _____

	A	B	C	D	E	F	G	H	I	J	K	L	M
2	6	5	4	3	2	1							
3													
4	7	8	9	10	11	12							
5													
6	18	17	16	15	14	13							
7													
8	19	20	21	22	23	24							
9													
10	30	29	28	27	26	25							
11													
12	31	32	33	34	35	36							
13													

I, Maurice J. Rosema in a field survey on April 1, 19 94
 do hereby certify that under requirements of P.A. 74, Michigan P.A. of 1970, the corner points mentioned
 in lines 1 and 2 above were in conformance with regulations and rules therefore as required in the
 current manual of survey instructions of the United States Department of the Interior, Bureau of Land
 Management or by a decree of a Court of Law and/or that the corner points mentioned in lines 3, 4 and 5
 above were in conformance with the rules of the Michigan Board of Land Surveyors or by a Decree of a
 Court of Law; established, re-established, monumented, re-monumented, recovered, found as
 expressed below:

**NOTE: Not more than 4 corners, all in the same town and range, may be recorded
 on this certificate.**

A. Description of original monument and accessories and/or subsequent restoration:

K-12	Rosema - 1984 per L.C.R.C.	Joiner - 1991 per L.C.R.C.
Clapp - 1972 per L.C.R.C.	rec. in L. 5, P. 152	rec. in L. 6, P. 164
rec. in L. 1, P. 797		
T-iron	1/2" rerod	C.I. mon.
12" quad. Cherry - W. 115.52'	Nail in E. side 15" quad. W.	Bldg. cor. - SW. 116.67'
T. pole - NW. 122.54'	Cherry - W. 115.46'	Face of 18" Cherry - W. 115.48'
Fc. post - E. 19.84'	P.K. nail in S. side wood fc.	12" Ash - E. 39.41'
T. pole - SW. 62.21'	post - E. 31.88'	T. pole -SE. 162.07'
	P.K. nail in SW. side P. pole	
	NNW. 126.56'	K-13, T7N, R14W - S. 2647.56'

B. Description of corner evidence found and/or method applied in restoring or reestablishing corner:


K-12	G.L.O. - 1832 - signed by Noah
Found C.I. mon. (top broken) - set mon. box above it	Brookfield for Calvin Britain D.S.
Found P.K. nail in SW. side P. pole - N10°W 126.54'	20" Maple - N77°E .15 ch. Set 1/2
Found nail in SW. side P. pole - S24°E 162.07'	28" Maple - S77°W .28 ch. mile post
NE. cor. metal bldg. - S71°W 116.69'	

I hereby accept this corner as a correct and
 accurate perpetuation of the position of the
 original corner.

RA. 345 OTTAWA COUNTY
 PEER APPROVED 11/21/94

C. Description of monument for corner and accessories established to perpetuate locating the position of the corner:

K-12
 C.I. mon. in mon. box
 Set nail and remon. tag in SW. side P. pole - N10°W 126.54'
 Set nail and remon. tag in SW. side P. pole - S24°E 162.09'
 Set nail and remon. tag in E. side 18" quad. W. Cherry - N86°W 115.37'
 Set nail and remon. tag in NE. side P. pole - N66°W 32.21'
 Set nail and remon. tag in N. side 12" Ash - S84°E 39.41'
 On c/l N.-S. bit. conc. road

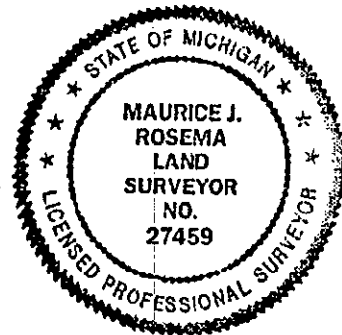

Signed by *Maurice J. Rosema* Date Nov. 19, 1994
 Surveyor's Michigan License No. 27459

FORM APPROVED BY MICHIGAN STATE BOARD OF LAND SURVEYORS, JAN. 28, 1971
 REVISED MAY 14, 1975
 REVISED JAN., 1983