

**SURVEY &  
REMONUMENTATION**

APR 05 1996

Ottawa County Remonumentation

RECORDED

95 DEC 12 PM 4:52

COMMISSION

**LAND CORNER RECORDATION CERTIFICATE**  
Filing Requirement of Act 74, Mich. P.A. 1970

For corners in

Ottawa _____ <small>(County)</small>	Located In:	Corner Code #
1. Public Land Survey	T T7N R R14W	L-3
	T _____ R _____	_____
	T _____ R _____	_____
	T _____ R _____	_____
2. Property Controlling in Section	S _____ T _____ R _____	_____
	S _____ T _____ R _____	_____
3. Miscellaneous Property in Sec.	S _____ T _____ R _____	_____
	S _____ T _____ R _____	_____
4. Lot No. _____, Recorded Plat _____		
5. Private Claims _____		

*Robert J. Chalmers*  
REGISTER OF DEEDS  
OTTAWA COUNTY, MI

Register of Deeds Stamp & File Number

Maurice J. Rosema in a field survey on April 11, 19 95  
do hereby certify that under requirements of P.A. 74, Michigan P.A. of 1970, the corner points mentioned in lines 1 and 2 above were in conformance with regulations and rules therefore as required in the current manual of survey instructions of the United States Department of the Interior, Bureau of Land Management or by a decree of a Court of Law and/or that the corner points mentioned in lines 3, 4 and 5 above were in conformance with the rules of the Michigan Board of Land Surveyors or by a Decree of a Court of Law; established, re-established, monumented, re-monumented, recovered, found as expressed below:

A	B	C	D	E	F	G	H	I	J	K	L	M
2	6	5	4	3	2	1						
3												
4	7	8	9	10	11	12						
5												
6	18	17	16	15	14	13						
7												
8	19	20	21	22	23	24						
9												
10	30	29	28	27	26	25						
11												
12	31	32	33	34	35	36						
13												

**NOTE: Not more than 4 corners, all in the same town and range, may be recorded on this certificate.**

A. Description of original monument and accessories and/or subsequent restoration:  
L-3

GLO - 1837 by John Mullett D.S. Set post 8" W. Ash S51°E 71 lks. 10" Elm S40°W 41 lks.	L.C.R.C. recorded in Liber 2, Page 689 - Oct. 22, 1974 T-iron 28" Ash NNE 47.98' 14" Maple SW 43.20'
--	--

Information from the files of Tru-Line Surveying P.C. - T-iron  
T fence post S 0.7' Nail and tag in S side 6" Ash W 2.70'  
Nail and tag in E side 30" Ash NNE 48.97 Nail and tag in SW side 6" Maple SE 18.77'

B. Description of corner evidence found and/or method applied in restoring or reestablishing corner:

L-3  
Found T-iron, replaced with 3/4" X 3' steel rod with O.C. cap  
Found nail and tag in SE side 6" Ash SE 18.85'  
Found nail and tag in E side 30" Ash NNE 49.05'  
T fence post S 0.7'


RA. 345 OTTAWA COUNTY  
PEER APPROVED 12/11/95

*Murray D. Hedewell*  
*MDH*

I hereby accept this corner as a correct and accurate perpetuation of the position of the original corner.

C. Description of monument for corner and accessories established to perpetuate locating the position of the corner:

L-3  
3/4" X 3' steel rod with O.C. cap  
Set nail and O.C. tag in SE side 6" Ash S46°E 18.85'  
Set nail and O.C. tag in S side 6" Ash S75°W 9.18'  
Set nail and O.C. tag in S side 5" dead tree N86°W 2.27'  
Set nail and O.C. tag in E side 30" Ash N19°E 49.05'  
Set nail and O.C. tag in SE side 20" Maple N34°E 44.97'  
T fence post S 0.7'

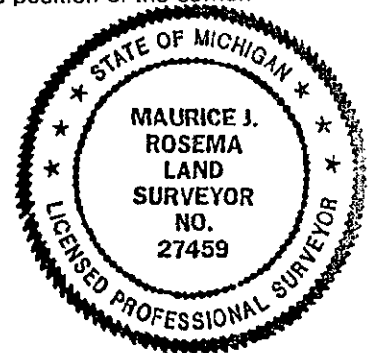

Signed by *Maurice J. Rosema*  
Surveyor's Michigan License No. 27459

Date November 20, 1995