

**SURVEY &
REMONUMENTATION**

Ottawa County Remonumentation
APR 05 1996 LAND CORNER RECORDATION CERTIFICATE

COMMISSION Filing Requirement of Act 74, Mich. P.A. 1970

For corners in

<u>Ottawa</u> <small>(County)</small>	Located In:	Corner Code #
	7N 14W	L-7
1. Public Land Survey	T _____ R _____	_____
	T _____ R _____	_____
	T _____ R _____	_____
	T _____ R _____	_____
2. Property Controlling in Section	S _____ T _____ R _____	_____
	S _____ T _____ R _____	_____
3. Miscellaneous Property in Sec.	S _____ T _____ R _____	_____
	S _____ T _____ R _____	_____

RECORDED
95 NOV 29 PM 1:46
Elizabeth Williams
REGISTER OF DEEDS
OTTAWA COUNTY, MI
Register of Deeds Stamp & File Number

4. Lot No. _____, Recorded Plat _____
5. Private Claims _____

Maurice J. Rosema Sept. 21 1995
I, _____, in a field survey on _____, 19____,
do hereby certify that under requirements of P.A. 74, Michigan P.A. of 1970, the corner points mentioned
in lines 1 and 2 above were in conformance with regulations and rules therefore as required in the
current manual of survey instructions of the United States Department of the Interior, Bureau of Land
Management or by a decree of a Court of Law and/or that the corner points mentioned in lines 3, 4 and 5
above were in conformance with the rules of the Michigan Board of Land Surveyors or by a Decree of a
Court of Law; established, re-established, monumented, re-monumented, recovered, found as
expressed below:

A	B	C	D	E	F	G	H	I	J	K	L	M
2	6	5	4	3	2	1						
3												
4	7	8	9	10	11	12						
5												
6	18	17	16	15	14	13						
7												
8	19	20	21	22	23	24						
9												
10	30	29	28	27	26	25						
11												
12	31	32	33	34	35	36						
13												

NOTE: Not more than 4 corners, all in the same town and range, may be recorded on this certificate.


A. Description of original monument and accessories and/or subsequent restoration:
L-7
Original gov't cor. L.C.R.C. per Liber 3, Page 361 (June 27, 1979) - over
set in 1832 by Noah Brookfield L.C.R.C. per Liber 5, Page 201 (Feb. 15, 1985) - over
Set post
7" Beech S30°E 20 lks. L.C.R.C. per Liber 6, page 157 (Sept. 13, 1995) - over
7" Beech N68°W 4 lks.

B. Description of corner evidence found and/or method applied in restoring or reestablishing corner:
L-7
Found Cast Iron monument
Found nail in SW side 18" tri. Maple S46°E 11.00'
Found nail in W side 24" Maple N31°E 48.13'
Found nail in NE side 18" Maple N23°W 52.55'

P.A. 345 OTTAWA COUNTY
PEER APPROVED 11-20-95
Kudoy P. Nedewell
K P N

I hereby accept this corner as a correct and accurate perpetuation of the position of the original corner.

C. Description of monument for corner and accessories established to perpetuate locating the position of the corner:
L-7
Cast Iron monument
Set nail and O.C. tag in SW side 18" tri. Maple S46°E 11.00'
Set nail and O.C. tag in E side 18" Maple S9°E 49.44'
Set nail and O.C. tag in W side 24" Maple N31°E 48.13'
Set nail and O.C. tag in NE side 18° Maple N23°W 52.55'

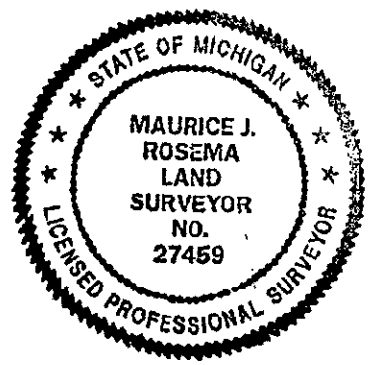

Signed by *Maurice J. Rosema* Date Nov. 14, 1995
Surveyor's Michigan License No. 27459

FORM APPROVED BY MICHIGAN STATE BOARD OF LAND SURVEYORS, JAN. 28, 1971
REVISED MAY 14, 1975
REVISED JAN., 1983

L-7, T7N, R14W

L.C.R.C. recorded in Liber 3, Page 361
- July 3, 1979

Steel Fence Post

10" Maple NNW 52.2'
24" Maple NNE 47.5'
16" Maple E 59.7'
16" Maple ESE 10.8'

L.C.R.C. recorded in Liber 5, Page 201
- February 15, 1985

Steel fence post

FEB 15
Nail in NE side 18" Maple NNW 52.43'
Nail in W side 18" Maple N 57.12'
Nail in W side 24" Maple NNE 48.11'
Nail in SW side Tri. 18" Maple ESE 11.12'
Nail in W side 18" Maple S 49.54'
On E-W fence line and on fence line to N
Tree row to S - E 10'

L.C.R.C. recorded in Liber 6, Page 157
September 13, 1991

C.I. Monument

SEPT. 13
18" Maple NNW 52.48'
24" Maple NNE 48.12'
Tri 18" Maple ESE 11.00'
18" Maple S 49.54'

\$ 11.00 CORNER