

LAND CORNER RECORDATION CERTIFICATE

93 DEC 15 AM 9:28

Filing Requirement of Act 74, Mich. P.A. 1970

REGISTER OF DEEDS OF TAWA COUNTY, MI

For corners in Ottawa

Table with columns: (County), Located In, Corner Code #. Rows include Public Land Survey, Property Controlling in Section, and Miscellaneous Property in Sec.

Register of Deeds Stamp & File Number

4. Lot No. , Recorded Plat
5. Private Claims

I, Maurice J. Rosema, in a field survey on July 31, 1993, do hereby certify that under requirements of P.A. 74, Michigan P.A. of 1970, the corner points mentioned in lines 1 and 2 above were in conformance with regulations and rules therefore as required in the current manual of survey instructions of the United States Department of the Interior, Bureau of Land Management or by a decree of a Court of Law and/or that the corner points mentioned in lines 3, 4 and 5 above were in conformance with the rules of the Michigan Board of Land Surveyors or by a Decree of a Court of Law; established, re-established, monumented, re-monumented, recovered, found as expressed below:

NOTE: Not more than 4 corners, all in the same town and range, may be recorded on this certificate.

A. Description of original monument and accessories and/or subsequent restoration:

- L-13 Clapp - 1972 per L.C.R.C. recorded in Liber 1, Page 797 C.I.M. Blendon Corner (iron bar) - E 5.75' 30" Oak - SE 20.27' 30" Oak - WSW 93.14' P. Pole - NW 46.91'
Prein and Newhof - 1991 per L.C.R.C. recorded in Liber 6, Page 205 C.I.M. P.K. in S side P. Pole - N45°W 46.93' Center top of hydrant - N45°E 45.65' 16-D nail in N side 6" Oak - S65°E 71.91' 16-D nail in W side 30" Oak - S10°E 21.05' P.K. in N side 14" Oak - S45°W 54.51' Blendon corner - East 5.77'
Prein and Newhof - 1993 per L.C.R.C. recorded in Liber 6, Page 258 C.I.M. P.K. in S. side P. Pole - N45°W 46.93' Center top of hydrant - N45°E 45.65' 16-D nail in N side 6" Oak - S65°E 71.91' 16-D nail in W side 30" Oak - S10°E 21.05' P.K. in N side 14" Oak - S45°W 54.51' Blendon corner - East 5.77'


B. Description of corner evidence found and/or method applied in restoring or reestablishing corner:

- L-13 Found P.K. nail in bit. conc. road Found P.K. nail in S side P. pole - N39°W 46.77' Found nail in W side 30" Oak - S10°E 21.08' Found nail in N side 9" Oak - S57°E 71.94' Center top of hydrant - N58°E 45.98' Magnetic pull (under bit. conc. roadway) - E 6'± On centerline of E-W bit. conc. road Centerline of gravel road to N - W 5'

I hereby accept this corner as a correct and accurate perpetuation of the position of the original section corner.

C. Description of monument for corner and accessories established to perpetuate locating the position of the corner:

- L-13 Set 5/8" x 36" steel bar and O.C. remon. cap in place of P.K. nail in bit. conc. road Set nail and O.C. remon. tag in S side P. pole - N39°W 46.77' Set nail and O.C. remon. tag in W side 30" Oak - S10°E 21.08' Set nail and O.C. remon. tag in N side 9" Oak - S57°E 71.94' Set nail and O.C. remon. tag in NW side P. Pole - S30°W 45.01' Center top of hydrant - N58°E 45.98'

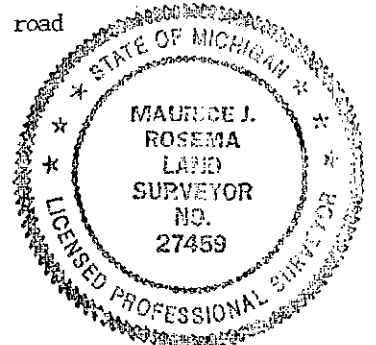

Signed by Maurice J. Rosema - Tru-Line Surveying Date September 3, 1993 Surveyor's Michigan License No. 27459