

RECORDED

OTTAWA COUNTY REMONUMENTATION
LAND CORNER RECORDATION CERTIFICATE 97 JUL 24 PM 2:26
Filing Requirement of Act 74, Mich. P.A. 1970

Deborah Ballman
REGISTER OF DEEDS
OTTAWA COUNTY, MI

For corners in

Ottawa
(County)

Located In:

Corner Code #

1. Public Land Survey	T	7N	R	14W	M-1 (NE, 1)
	T		R		Tallmadge Twp.
	T		R		
	T		R		
2. Property Controlling in Section	S		T	R	Common Corner
	S		T	R	
3. Miscellaneous Property in Sec.	S		T	R	
	S		T	R	

Register of Deeds Stamp & File Number

4. Lot No. _____, Recorded Plat _____
5. Private Claims _____

A	B	C	D	E	F	G	H	I	J	K	L	M
2	6	5	4	3	2	1						
3												
4	7	8	9	10	11	12						
5												
6	18	17	16	15	14	13						
7												
8	19	20	21	22	23	24						
9												
10	30	29	28	27	26	25						
11												
12	31	32	33	34	35	36						
13												

I, Donald W. Schiele, in a field survey on March 11, 1997, do hereby certify that under requirements of P.A. 74, Michigan P.A. of 1970, the corner points mentioned in lines 1 and 2 above were in conformance with regulations and rules therefore as required in the current manual of survey instructions of the United States Department of the Interior, Bureau of Land Management or by a decree of a Court of Law and/or that the corner points mentioned in lines 3, 4 and 5 above were in conformance with the rules of the Michigan Board of Land Surveyors or by a Decree of a Court of Law; established, re-established, monumented, re-monumented, recovered, found as expressed below:

NOTE: Not more than 4 corners, all in the same town and range, may be recorded on this certificate.

A. Description of original monument and accessories and/or subsequent restoration:

M-1 NE corner, Section 1, Tallmadge Twp.
 Original Government Corner Record: L.C.R.C. recorded in Liber 2, L.C.R.C. recorded in Liber 3, Page 330,
 Corner post of Towns 7 & 8 North, Ranges Page 379, 11-19-73 1-11-79
 13 & 14 West 3/4" Pipe in pavement Found 1" Round Iron by
 Post C/L street sign W 17.70' prev. witnesses
 Sugar 10 in dia bears S54W 10 lks dist Trans. pole SW 102.60' SW to PP 102.63'
 Do 8 " " " N33W 34 " " Tel. pole SE 114.03' SE to PP 114.4'
 John Mullett, Deputy Surveyor W. to St. Sign 17.67'
 March 13, 1837 (SEE REVERSE)

B. Description of corner evidence found and/or method applied in restoring or reestablishing corner:

M-1 Found Cast Iron Monument inscribed "Section Corner", 2" below surface in Monument Box, and accepted as a careful and faithful perpetuation of the position of the original corner.
 Found nail in SW side of Power Pole S22°30'E 114.44'
 Found nail & disk in NW side of Power Pole S22°30'E 114.07'
 Found nail in NE side of Power Pole S24°W 102.64'
 Westerly corner, concrete wingwall to House # 14430 N47°30'E 183.12' (E)
 NW corner, foundation to House # 14376 S40°30'E 167.75' (E)
 Fd. Ottawa County Remon Tag & nail in West side of Power Pole S22°30'E 114.44'
 Fd. Ottawa County Remon Tag & nail in East side of Power Pole S24°W 103.03'
 Fd. Ottawa County Remon Tag & nail in East side of Power Pole N13°W 210.38'
 Centerline asphalt road North & South, 8' East
 On centerline gravel road to East
 Field line to West, 18' South


P.A. 345 OTTAWA COUNTY

PEER APPROVED 4-21-97

C. Description of monument for corner and accessories established to perpetuate locating the position of the corner:

M-1 Cast Iron Monument inscribed "Section Corner", 2" below surface in Monument Box.
 Westerly corner, concrete wingwall to House # 14430 N47°30'E 183.12' (E)
 NW corner, foundation to House # 14376 S40°30'E 167.75' (E)
 Fd. Ottawa County Remon Tag & nail in West side of Power Pole S22°30'E 114.44'
 Fd. Ottawa County Remon Tag & nail in East side of Power Pole S24°W 103.03'
 Fd. Ottawa County Remon Tag & nail in East side of Power Pole N13°W 210.38'
 Centerline asphalt road North & South, 8' East
 On centerline gravel road to East
 Field line to West, 18' South

4 11.00 CORNER

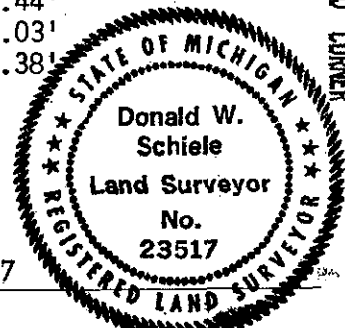

Signed by Donald W. Schiele
Surveyor's Michigan License No. 23517

Date March 15, 1997

Part A., continued:

L.C.R.C. recorded in Liber 6, Page 91, 1-28-91

A-1, T.7 N., R.13 W.

Set CIM

3" Apple	WSW	35.22'
PP	SW	102.67'
PP	SE	114.45'
14" Elm	NW	58.78'

L.C.R.C. recorded in Liber 3, Page 392, 10-24-79

1A, T.7 N., R.13 W.

Found 3/8" Iron

N45°W	Guy Pole	100.24'
S45°W	N. Line Pvmt	10.05'
S20°W	MBT Pole	110.90'

Note: This L.C.R.C. not correct location.
Refers to Section 1, T.7 N., R.13 W.

L.C.R.C. recorded in Remon Liber 2, Page 204, 12-15-94

M-13 (T8N, R14W)

Cast Iron Monument inscribed "Section Corner", 2" below surface in Monument Box.

Westerly corner, concrete wingwall to House # 14430	N47°30'E	183.12' (E)
NW corner, foundation to House # 14376	S40°30'E	167.75' (E)
Set Ottawa County Remon Tag & nail in West side of Power Pole	S22°30'E	114.44'
Set Ottawa County Remon Tag & nail in East side of Power Pole	S24°W	103.03'
Set Ottawa County Remon Tag & nail in East side of Power Pole	N13°W	210.38'
Centerline asphalt road North & South, 8' East		
On centerline gravel road to East		
Field line to West, 18' South		