

SURVEY &
REMONUMENTATION

APR 05 1996 Ottawa County Remonumentation

RECORDED

LAND CORNER RECORDATION CERTIFICATE
COMMISSION Filing Requirement of Act 74, Mich. P.A. 1970

95 DEC 12 PM 4:52

For corners in

<u>Ottawa</u> (County)	Located In:	Corner Code #
1. Public Land Survey	T <u>T7N</u> R <u>R14W</u>	<u>M-2</u>
	T _____ R _____	_____
	T _____ R _____	_____
	T _____ R _____	_____
2. Property Controlling in Section	S _____ T _____ R _____	_____
	S _____ T _____ R _____	_____
3. Miscellaneous Property in Sec.	S _____ T _____ R _____	_____
	S _____ T _____ R _____	_____

D. J. ...
REGISTER OF DEEDS
OTTAWA COUNTY, MI

Register of Deeds Stamp & File Number

4. Lot No. _____, Recorded Plat _____
5. Private Claims _____

	A	B	C	D	E	F	G	H	I	J	K	L	M
2	6	5	4	3	2	1							
3													
4	7	8	9	10	11	12							
5													
6	16	17	16	15	14	13							
7													
8	19	20	21	22	23	24							
9													
10	30	29	28	27	26	25							
11													
12	31	32	33	34	35	36							
13													

I, Maurice J. Rosema, in a field survey on Oct. 17, 1995, do hereby certify that under requirements of P.A. 74, Michigan P.A. of 1970, the corner points mentioned in lines 1 and 2 above were in conformance with regulations and rules therefore as required in the current manual of survey instructions of the United States Department of the Interior, Bureau of Land Management or by a decree of a Court of Law and/or that the corner points mentioned in lines 3, 4 and 5 above were in conformance with the rules of the Michigan Board of Land Surveyors or by a Decree of a Court of Law; established, re-established, monumented, re-monumented, recovered, found as expressed below:

NOTE: Not more than 4 corners, all in the same town and range, may be recorded on this certificate.

A. Description of original monument and accessories and/or subsequent restoration:

M-2	GLO - 1837 by John Mullett D.S.	L.C.R.C. recorded in Liber 6, Page 93 - Jan. 28, 1991 (recorded as A-2, T7N, R13W)	L.C.R.C. recorded in Liber 2, Page 121 - May, 1973 (recorded as A-2, T7N, R13W)
	Set post	C.I. mon.	RR Spk.
	16" Sugar S6 1/2°W 36 lks.	P pole	SE hse. cor. NW 81.6'
	13" Sugar N57°W 33 lks.	32" Walnut	30" Walnut SW 40.5'
		SE cor. hse. fndn.	36" Maple NW 43.3'
		36" Maple	
		ESE 34.62'	
		SW 40.02'	
		NW 81.65'	
		NW 43.40'	

B. Description of corner evidence found and/or method applied in restoring or reestablishing corner:

M-2	Found C.I. mon. in mon. box	
	Found nail in SE side 33" Walnut	S52°W 40.01'
	SE cor. hse. fndn.	N70°W 81.74'
	Found nail in S side 37" Maple	N48°W 43.39'
	Found nail in W side P pole	S73°E 63.10'

PA. 345 OTTAWA COUNTY


PEER APPROVED 12/11/95

I hereby accept this corner as a correct and accurate perpetuation of the position of the original corner.

Kudoy P. ...
YOT

C. Description of monument for corner and accessories established to perpetuate locating the position of the corner:

M-2	C.I. mon. in mon. box	
	Set nail and O.C. tag in SE side 33" Walnut	S52°W 40.01'
	SE cor. hse. fndn.	N70°W 81.74'
	Set nail and O.C. tag in S side 37" Maple	N48°W 43.39'
	Set nail and O.C. tag in N side P pole	S73°E 34.96'
	Set nail and O.C. tag in SW side 30" Walnut	S45°E 63.10'
	Centerline of N-S bit. conc. road	E 2'

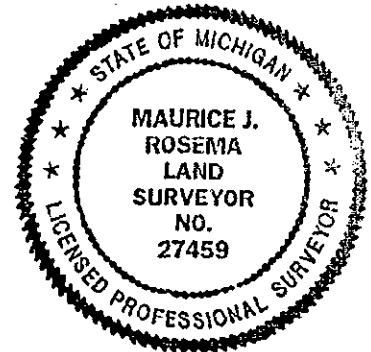

Signed by *Maurice J. Rosema* Date Dec. 9, 1995

Surveyor's Michigan License No. 27459

FORM APPROVED BY MICHIGAN STATE BOARD OF LAND SURVEYORS, JAN. 28, 1971
REVISED MAY 14, 1975
REVISED JAN., 1983