

SURVEY &
MONUMENTATION

Ottawa County Remonumentation

APR 05 1996

LAND CORNER RECORDATION CERTIFICATE

Filing Requirement of Act 74, Mich. P.A. 1970

For corners in **COMMISSION**

Ottawa (County)	Located In:	Corner Code #
1. Public Land Survey	T T7N R R14W	M-3
	T _____ R _____	_____
	T _____ R _____	_____
	T _____ R _____	_____
2. Property Controlling in Section	S _____ T _____ R _____	_____
	S _____ T _____ R _____	_____
3. Miscellaneous Property in Sec.	S _____ T _____ R _____	_____
	S _____ T _____ R _____	_____
4. Lot No. _____, Recorded Plat _____		
5. Private Claims _____		

RECORDED

95 DEC 12 PM 4: 52

Deborah C. Caldwell
REGISTER OF DEEDS
OTTAWA COUNTY, MI

Register of Deeds Stamp & File Number

Maurice J. Rosema, in a field survey on Jan. 24, 1995, do hereby certify that under requirements of P.A. 74, Michigan P.A. of 1970, the corner points mentioned in lines 1 and 2 above were in conformance with regulations and rules therefore as required in the current manual of survey instructions of the United States Department of the Interior, Bureau of Land Management or by a decree of a Court of Law and/or that the corner points mentioned in lines 3, 4 and 5 above were in conformance with the rules of the Michigan Board of Land Surveyors or by a Decree of a Court of Law; established, re-established, monumented, re-monumented, recovered, found as expressed below:

NOTE: Not more than 4 corners, all in the same town and range, may be recorded on this certificate.

A. Description of original monument and accessories and/or subsequent restoration:

M-3	L.C.R.C. recorded in Liber	L.C.R.C. recorded in Liber
GLO - 1837 by	John Mullett D.S.	2, Page 689 - Oct. 22, 1974
Set post	3/4" steel bar in pav't	3/4" steel bar in pav't
12" Sugar S8 1/2°W 53 lks.	c/l st. sign	SE 30.27'
24" Sugar N46°W 6 lks.	MBT	NW 40.96'
	Fence cor.	SW 38.50'

B. Description of corner evidence found and/or method applied in restoring or reestablishing corner:

M-3
Found C.I. mon. in mon. box


RA. 345 OTTAWA COUNTY
PEER APPROVED 12/11/95

Murray D. Redwood
MDR

I hereby accept this corner as a correct and accurate perpetuation of the position of the original corner.

C. Description of monument for corner and accessories established to perpetuate locating the position of the corner:

M-3		
C.I. mon. in mon. box		
Set nail and O.C. tag in NE side P pole	S30°E	60.86'
Set nail and O.C. tag in NE side 26" Elm	S54°E	63.92'
Set nail and O.C. tag in SE side wood post	S20°W	110.10'
Center of stop sign	S37°E	40.36'
Set nail and O.C. tag in NE side P pole	N50°W	66.65'
Set nail and O.C. tag in S side 5" tw Maple	N80°E	85.86'
Centerline of N-S bit. conc. road	W	2.5'
Centerline of E-W gravel road	S	1.5'

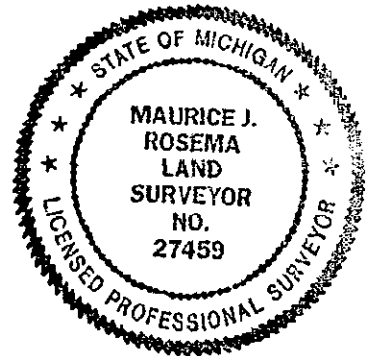

Signed by *Maurice J. Rosema*
Surveyor's Michigan License No. 27459

Date Nov. 20, 1995