

**SURVEY &
REMONUMENTATION**

Ottawa County Remonumentation

APR 05 1996

LAND CORNER RECORDATION CERTIFICATE

Filing Requirement of Act 74, Mich. P.A. 1970

For corners in **COMMISSION**

<u>Ottawa</u> <small>(County)</small>	Located in:	Corner Code #
1. Public Land Survey	T <u>7N</u> R <u>14W</u>	M-4
	T _____ R _____	(E $\frac{1}{4}$ cor of
	T _____ R _____	Section 12)
	T _____ R _____	Allendale Twp
2. Property Controlling in Section	S _____ T _____ R _____	_____
	S _____ T _____ R _____	_____
3. Miscellaneous Property in Sec.	S _____ T _____ R _____	_____
	S _____ T _____ R _____	_____

RECORDED

95 NOV 29 PM 1:37

Richard L. Rosema
REGISTER OF DEEDS
OTTAWA COUNTY, MI

Register of Deeds Stamp & File Number

4. Lot No. _____, Recorded Plat _____
5. Private Claims _____

A	B	C	D	E	F	G	H	I	J	K	L
2	6	5	4	3	2	1					
3											
4	7	8	9	10	11	12					
5											
6	16	17	16	15	14	13					
7											
8	19	20	21	22	23	24					
9											
10	30	29	28	27	26	25					
11											
12	31	32	33	34	35	36					
13											

I, Maurice J. Rosema, in a field survey on Jan. 24, 1995, do hereby certify that under requirements of P.A. 74, Michigan P.A. of 1970, the corner points mentioned in lines 1 and 2 above were in conformance with regulations and rules therefore as required in the current manual of survey instructions of the United States Department of the Interior, Bureau of Land Management or by a decree of a Court of Law and/or that the corner points mentioned in lines 3, 4 and 5 above were in conformance with the rules of the Michigan Board of Land Surveyors or by a Decree of a Court of Law; established, re-established, monumented, re-monumented, recovered, found as expressed below:

NOTE: Not more than 4 corners, all in the same town and range, may be recorded on this certificate.

A. Description of original monument and accessories and/or subsequent restoration:

M-4
GLO - 1837 (John Mullett D.S.) L.C.R.C. recorded in Liber 2, Page 523 - July 9, 1974
6" Beech S12°E 70 lks C.I. Monument (recorded as A-4, T7N, R13W)
9" Beech N2 $\frac{1}{2}$ °W 50 lks Iron at c/l Leonard Rd S 193.06'
SW corner gar. NE 125.05'
L.C.R.C. recorded in Liber 2, SE corner barn NNW 103.35' 10" Apple E 38.22'
Page 525 - June 3, 1974
C.I. Monument
SW corner gar. NE 125.05' Iron at c/l Leonard Rd S 193.06'
SE corner barn NNW 103.35' Fence to E E 38.22'


B. Description of corner evidence found and/or method applied in restoring or reestablishing corner:

M-4
Found C.I. Monument in monument box
SW corner gar. NE 124.88'

P.A. 345 OTTAWA COUNTY

PEER APPROVED 11/20/95

Richard L. Rosema

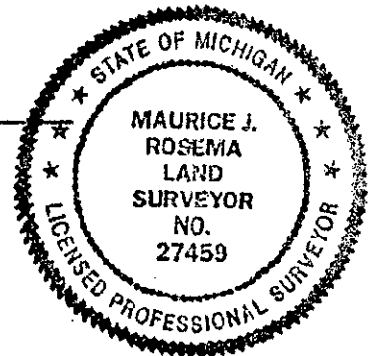

I hereby accept this corner as a correct and accurate perpetuation of the position of the original corner.

C. Description of monument for corner and accessories established to perpetuate locating the position of the corner:

M-4
C.I. Monument in monument box
Set nail and Ottawa County remon. tag in SE side 5" tw Pine S42°W 40.45'
Set nail and Ottawa County remon. tag in SE side wood fc post S37°E 45.51'
Set nail and Ottawa County remon. tag in NE side 12" Pine N34°W 43.45'
Set nail and Ottawa County remon. tag in S side 10" Pine S90°W 26.50'
Set nail and Ottawa County remon. tag in S side 13" Apple S82°E 39.25'
In S-bound lane of N-S bit. conc. road

Signed by *Maurice J. Rosema* Date October 21, 1995
Surveyor's Michigan License No. 27459