

Ottawa County Remonumentation
LAND CORNER RECORDATION CERTIFICATE
 Filing Requirement of Act 74, Mich. P.A. 1970

RECORDED

96 DEC 18 PM 4:56

For corners in

Ottawa

(County)

Located In:

Corner Code #

- | | | | | | | |
|------------------------------------|---|-----------|---|------------|-----------|-------|
| 1. Public Land Survey | T | <u>7N</u> | R | <u>14W</u> | M-5 | |
| | T | _____ | R | _____ | (SE cor.) | |
| | T | _____ | R | _____ | Sec. 12) | |
| | T | _____ | R | _____ | _____ | |
| 2. Property Controlling in Section | S | _____ | T | _____ | R | _____ |
| | S | _____ | T | _____ | R | _____ |
| 3. Miscellaneous Property in Sec. | S | _____ | T | _____ | R | _____ |
| | S | _____ | T | _____ | R | _____ |

Richard A. Anderson
 REGISTER OF DEEDS
 OTTAWA COUNTY, MI

Register of Deeds Stamp & File Number

4. Lot No. _____, Recorded Plat _____
 5. Private Claims _____

	A	B	C	D	E	F	G	H	I	J	K	L	M
2	6		5		4		3		2		1		
3													
4	7		8		9		10		11		12		
5													
6	18		17		16		15		14		13		
7													
8	19		20		21		22		23		24		
9													
10	30		29		28		27		26		25		
11													
12	31		32		33		34		35		36		
13													

I, Maurice J. Rosema, in a field survey on Dec. 9, 1996, do hereby certify that under requirements of P.A. 74, Michigan P.A. of 1970, the corner points mentioned in lines 1 and 2 above were in conformance with regulations and rules therefore as required in the current manual of survey instructions of the United States Department of the Interior, Bureau of Land Management or by a decree of a Court of Law and/or that the corner points mentioned in lines 3, 4 and 5 above were in conformance with the rules of the Michigan Board of Land Surveyors or by a Decree of a Court of Law; established, re-established, monumented, re-monumented, recovered, found as expressed below:

NOTE: Not more than 4 corners, all in the same town and range, may be recorded on this certificate.

A. Description of original monument and accessories and/or subsequent restoration:

M-5

GLO - 1837 by Mullett
 Post on edge of pond hole
 12" Maple - N1½°W 36 lks

Information from the files of:
 Williams and Works
 Nederveld Associates
 Tru-Line Surveying P.C.

B. Description of corner evidence found and/or method applied in restoring or reestablishing corner:

M-5

Section corner falls in water in swamp, set witness corners North and South of M-5 on the Section line (see sketch on reverse side).

I hereby accept this corner as a correct and accurate perpetuation of the position of the original corner.


P.A. 345 OTTAWA COUNTY
 PEER APPROVED 12-9-96

M. J. Rosema

C. Description of monument for corner and accessories established to perpetuate locating the position of the corner:

M-5

See reverse side for witness corner information.

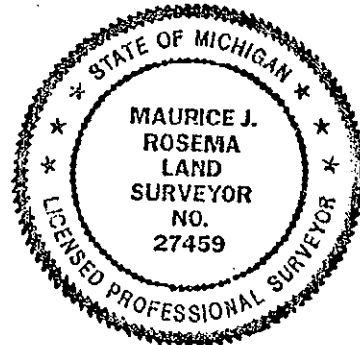

Signed by Maurice J. Rosema

Date Dec. 9, 1996

Surveyor's Michigan License No. 27459

FORM APPROVED BY MICHIGAN STATE BOARD OF LAND SURVEYORS, JAN. 20, 1971
 REVISED MAY 14, 1971
 REVISED JAN., 1998

M-5 - Part C continued:

Witness corner A:

Set 5/8" x 3' steel rod with remon. cap on Section line between M-4 and M-5

Section corner M-5 (not set) - South 823.99'

Nail and remon. tag in S side 12" Maple - N72°E 21.22'

Nail and remon. tag in W side 6" Maple clump - N8°W 11.79'

Nail and remon. tag in NE side 5" Hackberry - N65°W 8.20'

Nail and remon. tag in S side 12" Ash - N85°W 37.68'

Nail and remon. tag in N side 24" Sycamore - S75°E 34.30'

North edge of the Grand River - S 12'±

Witness corner B:

Set 5/8" x 3' steel rod with remon. cap on Section line between M-5 and M-6

Section corner M-5 (not set) - North 500.00'

Nail and remon. tag in W side twin 24" Maple - S10°E 19.01'

Nail and remon. tag in S side 6" Ash - N70°W 19.55'

Nail and remon. tag in N side 6" Ash - N50°W 20.25'

Nail and remon. tag in E side 10" Ash - N28°W 26.80'

Nail and remon. tag in E side 12" Ash - N12°E 60.50'

South edge of swamp brush (on South side of bayou) - N 60'±

